

LABOR AND MATERIALS


1 Copper } Connection $3/4"$ \$
 Lead }
 1 Curb } Cock } $3/4$ in. $MAY 21$ \$
 Valve } 0715 \$
 T.S. & V. }
 1 Service box } { Short $3/4$ x $4 1/2$ } $4' \times 5'$ \$
 Old returned } { Long $4 1/2$ x $5 1/2$ } \$
 Buff or Rdway } \$
 18 FT $3/4$ in. } { Copper } Pipe at \$
 C.P. }
 C.P. }
 Nipples in. at \$
 Bushings to in. at \$
 Red'g }
 Inc'g } Coupl'gs to in. at \$
 Union in. at \$
 Meter in. at \$
 Lead Joints at \$
 Compound Joints at \$
 Maintenance Foreman \$
 Hrs. Water Maint. Man-1 at \$
 Hrs. Water Maint. Man-2 at \$
 Hrs. Garage Foreman at \$
 Hrs. Labor at \$
 Hrs. Compressor at \$
 Compensation Ins. at \$ per C \$
 Trucking \$
 Pav't Patch \$
 TRP Made By B. E. FORD \$
 O'head $JUNE - 7 - 19 74$ \$

KAY 5-23-2001

ORVILLE St.
 Ft.
 Ave. No. 10

Name of Owner W. J. ABBOTT

Labor and Mat'l. Report JUNE 7 19 74

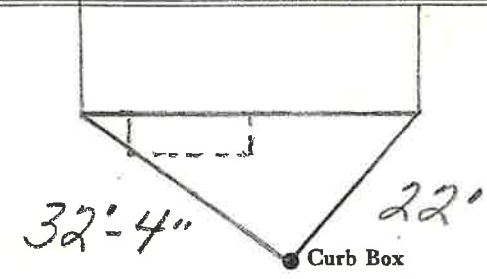

6" Main Elev. of
 Main at tap 5 1/2'

Gate at • • Gate at

TAX ID # 302.20-25-12

• Curb Box