

LABOR AND MATERIALS


Copper	} Connection		\$
Lead			
Curb	} Cock Valve T. S. & V.	in.	\$
Service box	} Short 3 1/2 x 4 1/2 } Long 4 1/2 x 5 1/2 }		\$
Old returned			
7'6" Ft.	} Copper } } G.I. } } G.I. }	3/4 in. Pipe at	\$
Nipples	in. at		\$
Bushings	to in. at		\$
Red'g	} Coupl'gs	to in. at	\$
Inc'g			
Union	in. at		\$
Meter	in. at		\$
			\$
Compound Joints	at		\$
Maintenance Foreman			\$
Hrs. Water Maint. Man-1	at		\$
Hrs. Water Maint. Man-2	at		\$
Hrs. Garage Foreman	at		\$
Hrs. Labor	at		\$
Hrs. Compressor	at		\$
			\$
Trucking			\$
Pav't Patch			\$
			\$
			\$
			\$
			\$

St. ORVILLE Ave. No. 11

Name of Owner

TAX ID # 302.20-20-14

Labor and Mat'l. Report 1997

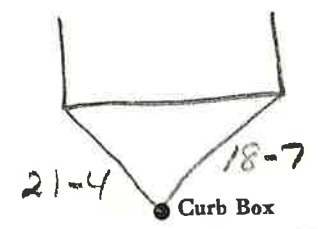

6" Main Elev. of Main at tap

Gate at • • Gate at

• Curb Box