


LABOR AND MATERIALS

Copper } Connection _____	\$ _____
Lead } _____	\$ _____
Curb } Cock } _____ in.	\$ _____
} Valve } _____	
} T. S. & V. } _____	
Service box } { Short 3½ x 4½ }	\$ _____
Old returned } { Long 4½ x 5½ }	
6 Ft. ¾ in. } { Copper } Pipe at _____	\$ _____
} { C.I. } _____	
} { C.I. } _____	
Nipples _____ in. at _____	\$ _____
Bushings _____ to _____ in. at _____	\$ _____
Red'g } _____	\$ _____
Inc'g } Coupl'gs _____ to _____ in. at _____	
Union _____ in. at _____	\$ _____
Meter _____ in. at _____	\$ _____
_____	\$ _____
Compound Joints at _____	\$ _____
Maintenance Foreman _____	\$ _____
Hrs. Water Maint. Man—1 at _____	\$ _____
Hrs. Water Maint. Man—2 at _____	\$ _____
Hrs. Garage Foreman _____ at _____	\$ _____
Hrs. Labor— _____ at _____	\$ _____
Hrs. Compressor at _____	\$ _____
_____	\$ _____
Trucking _____	\$ _____
Pav't Patch _____	\$ _____
_____	\$ _____
_____	\$ _____
_____	\$ _____
_____	\$ _____

ORVILLE St. Pl. Ave. No. 13

Name of Owner
TAX ID # 302.20-20-13

Labor and Mat'l. Report 1997

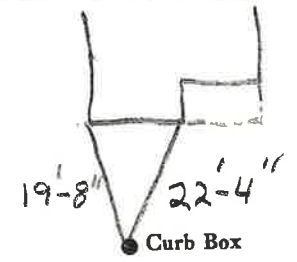

6" Main Elev. of Main at tap _____
Gate at • Gate at •

• Curb Box