


LABOR AND MATERIALS

1 Copper	Connection 1"	\$ 4.28
Lead		
1 Curb	Cock Valve T.S. & V. } 1 in.	\$ 5.25
Service box <del>Old returned</del>		
	Short 3 1/2 X 4 1/2 Long 4 1/2 X 5 1/2 Buff or Rdway	\$ 4.74
30 Ft. 1 in. Copper	Pipe at 47	\$ 14.10
Nipples	in. at	\$
Bushings	to in. at	\$
Red'g / Inc'g	Coupl'gs to in. at	\$
Union	in. at	\$
Meter	in. at	\$
Lead Joints	at	\$
Compound Joints	at	\$
Hrs. Water Maint. Man-1	at	\$
18 Hrs. Water Maint. Man-2	at 1.24	\$ 22.32
30 Hrs. Labor	at 1.13	\$ 33.90
Hrs. Labor	at	\$
4 Hrs. Compressor	at 1.50	\$ 6.00
Compensation Ins.	at \$ 4.40 per C.	\$ 2.48
Trucking		\$ 1.00
Pav't Patch		\$ 21.84
Tap by J. S. Ford 9-22-53		\$
O'head		\$
		\$
		\$
		\$ 115.91

94.07

10-53  
Corner of Glen & Park St.  
Park Ave. No. 2-4-6

Name of Owner Ginsberg  
Niagara Mohawk Power Corp.  
Labor and Mat'l. Report Sept. 22 19 53

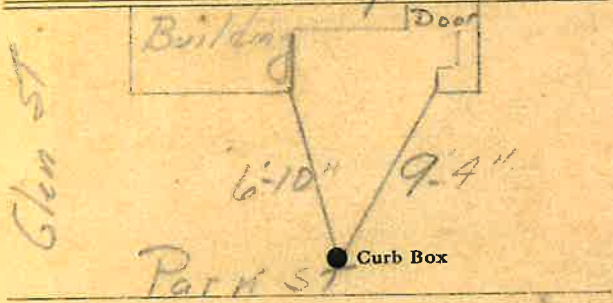

8" Main Elev. of Main at tap 5'  
Gate at Gate at  
● Curb Box

Tap on Park St.