


**LABOR AND MATERIALS**

1" Copper Connection \_\_\_\_\_ \$ \_\_\_\_\_  
Lead }  
 Curb } Cock \_\_\_\_\_ in. \_\_\_\_\_ \$ \_\_\_\_\_  
 } Valve }  
 } T.S. & V. }  
 Service box { Short 3-1/2 x 4-1/2 } \_\_\_\_\_ \$ \_\_\_\_\_  
 Old returned { Long 4-1/2 x 5-1/2 } \_\_\_\_\_ \$ \_\_\_\_\_  
 4 Ft. 6 in. { Copper } Pipe at \_\_\_\_\_ \$ \_\_\_\_\_  
 } G.I. }  
 } C.I. }  
 Nipples \_\_\_\_\_ in. at \_\_\_\_\_ \$ \_\_\_\_\_  
 Bushings \_\_\_\_\_ to \_\_\_\_\_ in. at \_\_\_\_\_ \$ \_\_\_\_\_  
 Red'g \_\_\_\_\_  
 Inc'g \_\_\_\_\_  
 Union \_\_\_\_\_ in. at \_\_\_\_\_ \$ \_\_\_\_\_  
 Meter \_\_\_\_\_ in. at \_\_\_\_\_ \$ \_\_\_\_\_  
 \_\_\_\_\_ \$ \_\_\_\_\_  
 Compound Joints at \_\_\_\_\_ \$ \_\_\_\_\_  
 Maintenance Foreman \_\_\_\_\_ \$ \_\_\_\_\_  
 Hrs. Water Maint. Man - 1 at \_\_\_\_\_ \$ \_\_\_\_\_  
 Hrs. Water Maint. Man - 2 at \_\_\_\_\_ \$ \_\_\_\_\_  
 Hrs. Garage Foreman \_\_\_\_\_ at \_\_\_\_\_ \$ \_\_\_\_\_  
 Hrs. Labor \_\_\_\_\_ at \_\_\_\_\_ \$ \_\_\_\_\_  
 Hrs. Compressor at \_\_\_\_\_ \$ \_\_\_\_\_  
 \_\_\_\_\_ \$ \_\_\_\_\_  
 Trucking \_\_\_\_\_ \$ \_\_\_\_\_  
 Pav't Patch \_\_\_\_\_ \$ \_\_\_\_\_  
 \_\_\_\_\_ \$ \_\_\_\_\_  
 \_\_\_\_\_ \$ \_\_\_\_\_  
 \_\_\_\_\_ \$ \_\_\_\_\_  
 \_\_\_\_\_ \$ \_\_\_\_\_

PARK St. Pl. 15-25 Ave. No.

Name of Owner \_\_\_\_\_

Labor and Mat'l. Report to 9/15/2008

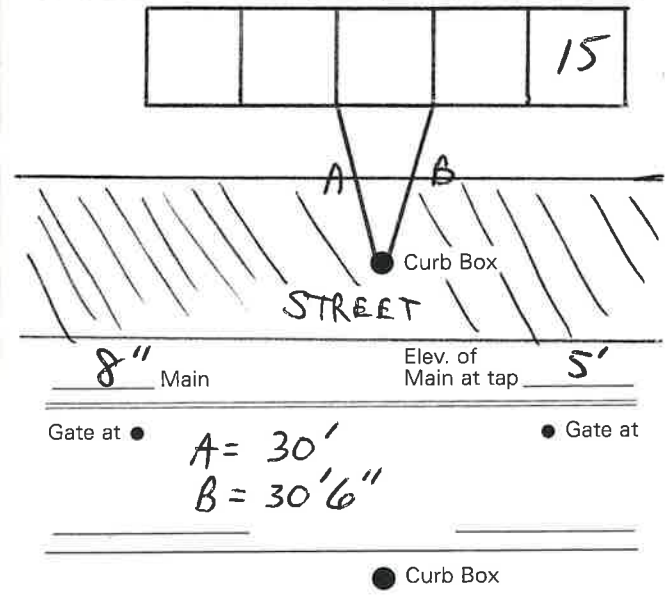

Gate at • A = 30' • Gate at  
 B = 30'6"

OLD TAP DISCONNECTED

NEW TAP INSTALLED

TAX ID # 309.28-4-1 9/15

**Labor and Materials**

1/4 Lead Connection ..... \$  
 1/2 Curb Cock ..... \$  
 1 Service Box { Short 31 x 41 } ..... \$  
 Old returned { Long 41 x 61 } ..... \$  
 Buffalo gate box  
 1/2 Ft. in. G. I. Pipe at ..... \$ 35  
 Nipples in. at ..... \$  
 Bushings to in. at ..... \$  
 Red'g Coup to in. at ..... \$  
 Inc'g Coup to in. at ..... \$  
 Unfon in. at ..... \$  
 Meter in. at ..... \$  
 Cu. Yds. Br. Stone at ..... \$  
 Cu. Yds. Sand at ..... \$  
 Bags Cement at ..... \$  
 Paving Brick { Mack } at ..... \$  
 { Red }  
 { Asphalt }  
 6 Hrs. Foreman at ..... \$  
 12 Hrs. Common Labor at ..... \$  
 Hrs. Mason at ..... \$  
 Hrs. at ..... \$  
 Hrs. at ..... \$  
 Builders' Use of Water ..... \$  
 Truck 1.00 ..... \$  
 at ..... \$  
 at ..... \$  
 at ..... \$  
 Total \$ 35.75

**and Material Report**

1928

114' tap at cor. Church Park  
 26' 10"  
 32' 11"  
 Curb Box  
 Main Elev. of Main at tap  
 Gate at Curb Box Gate at