


### Labor and Materials

..... Lead Connection .....	\$
..... Curb Cock .....	\$
..... Service Box (Short 3" x 4" / Old returned (Long 4" x 5" / Buffalo)	\$
..... Ft. .... in. G. I. Pipe at .....	\$
..... Nipples..... in. at .....	\$
..... Bushings..... to..... in. at .....	\$
..... Red'g Coup..... to..... in. at .....	\$
..... Inc'g Coup..... to..... in. at .....	\$
..... Union..... in. at .....	\$
..... Meter..... in. at .....	\$
..... Cu. Yds. Br. Stone at.....	\$
..... Cu. Yds. Sand at.....	\$
..... Bags Cement at.....	\$
..... Paving Brick { Mack / Red / Asphalt } at.....	\$
..... 7 Hrs. Foreman at .....	\$
..... 1.0 Hrs. Common Labor at.....	\$
..... Hrs. Mason at.....	\$
..... Hrs..... at.....	\$
..... Hrs..... at.....	\$
..... Builders' Use of Water .....	\$
..... at.....	\$
..... at.....	\$
..... at.....	\$
..... at.....	\$
..... Total	\$ 18.41

### Labor and Material Report

19 ..

3248

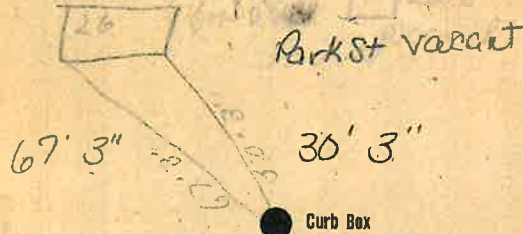

Main	Elev. of Main at tap
Gate at ●	● Gate at

● Curb Box