


PARK

St. ~~17~~
Ave. No. 39

Name of Owner

Labor and Mat'l. Report Oct 12 19 82

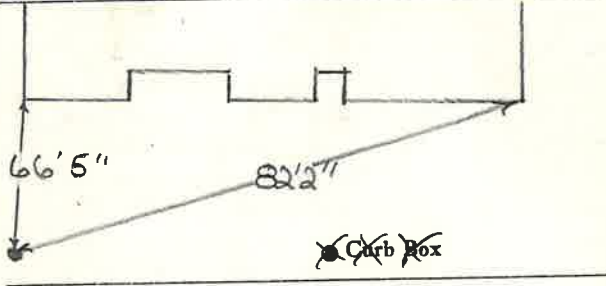

6 Main

Elev. of Main at tap 4'

Gate at ●

● Gate at

removed tap

Oct.

● Curb Box

16 192


39. Park St

St. ~~17~~
Ave. No. 39

Name of Owner

Phasier Paint Co.

Labor and Mat'l. Report Mar. 27 19 51

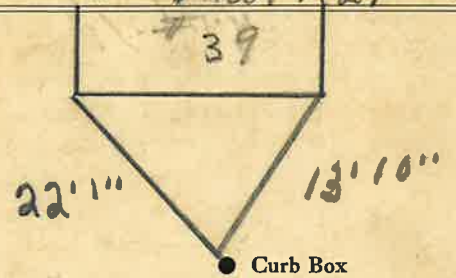

6" Main

Elev. of Main at tap 5'

Gate at ●

● Gate at

● Curb Box

LABOR AND MATERIALS

Copper } Connection	_____	\$ _____
Lead } _____	_____	\$ _____
Curb } Cock Valve	_____ in.	\$ _____
} T. S. & V. }	_____	\$ _____
Service box } Short 3½ x 4½	_____	\$ _____
Old returned } Long 4½ x 5½	_____	\$ _____
} Buff or Rdway }	_____	\$ _____
33 Ft. 0 in. } Copper	_____ Pipe at	\$ _____
} C.I. }	_____	\$ _____
} C.I. }	_____	\$ _____
Nipples _____ in. at	_____	\$ _____
Bushings _____ to _____ in. at	_____	\$ _____
Red'g } Coupl'gs _____ to _____ in. at	_____	\$ _____
Inc'g } _____	_____	\$ _____
Union _____ in. at	_____	\$ _____
Meter _____ in. at	_____	\$ _____
Lead Joints at	_____	\$ _____
Compound Joints at	_____	\$ _____
Maintenance Foreman	_____	\$ _____
Hrs. Water Maint. Man-1 at	_____	\$ _____
Hrs. Water Maint. Man-2 at	_____	\$ _____
Hrs. Garage Foreman _____ at	_____	\$ _____
Hrs. Labor _____ at	_____	\$ _____
Hrs. Compressor at	_____	\$ _____
Compensation Ins. at \$ _____ per C.	_____	\$ _____
Trucking	_____	\$ _____
Pav't Patch	_____	\$ _____
_____	_____	\$ _____
_____	_____	\$ _____
_____	_____	\$ _____
_____	_____	\$ _____
O'head	_____	\$ _____
_____	_____	\$ _____

LABOR AND MATERIALS

¾" Copper } Connection	_____	\$ 3.04
Lead } _____	_____	\$ _____
¾" Curb } Cock Valve	_____ in.	\$ 3.54
} T. S. & V. }	_____	\$ _____
1 Service box } Short 3½ x 4½	_____	\$ _____
Old returned } Long 4½ x 5½	_____	\$ 4.70
} Buff or Rdway }	_____	\$ _____
14 Ft. ¾ in. } Copper	_____ Pipe at 35	\$ 4.90
} C.I. }	_____	\$ _____
} C.I. }	_____	\$ _____
Nipples _____ in. at	_____	\$ _____
Bushings _____ to _____ in. at	_____	\$ _____
Red'g } Coupl'gs _____ to _____ in. at	_____	\$ _____
Inc'g } _____	_____	\$ _____
Union _____ in. at	_____	\$ _____
Meter _____ in. at	_____	\$ _____
Lead Joints at	_____	\$ _____
Compound Joints at	_____	\$ _____
Hrs. Water Maint. Man-1 at	_____	\$ _____
10 Hrs. Water Maint. Man-2 at 1.13	_____	\$ 11.30
32 Hrs. Labor _____ at 1.02	_____	\$ 32.64
Hrs. Labor _____ at	_____	\$ _____
4 Hrs. Compressor at 1.50	_____	\$ 6.00
Compensation Ins. at \$ 2.66 per C.	_____	\$ 1.17
Trucking	_____	\$ 1.00
Pav't Patch	_____	\$ 11.20
_____	_____	\$ _____
_____	_____	\$ _____
_____	_____	\$ _____
_____	_____	\$ _____
O'head	_____	\$ _____
_____	_____	\$ 79.49

69.29