

### LABOR AND MATERIALS

Copper	}	Connection		\$		
Lead						
Curb	}	Cock	} in.	\$		
		Valve				
		T. S. & V.				
Service box	}	Short 3½ x 4½	}	\$		
Old returned		Long 4½ x 5½				
Ft.	}	Copper	} Pipe at	\$		
in.		G. I.				
		C. I.				
Nipples	in.	at		\$		
Bushings	to	in.	at	\$		
Red'g	}	Coupl'gs	to	in.	at	\$
Inc'g						
Union	in.	at		\$		
Meter	in.	at		\$		
				\$		
Compound Joints	at			\$		
Maintenance Foreman				\$		
Hrs. Water Maint. Man—1	at			\$		
Hrs. Water Maint. Man—2	at			\$		
Hrs. Garage Foreman	at			\$		
Hrs. Labor—	at			\$		
Hrs. Compressor	at			\$		
				\$		
Trucking				\$		
Pav't Patch				\$		
				\$		
				\$		
				\$		
				\$		


PARK

St.  
~~Pl.~~ No. 412  
Ave. No.

Name of Owner

Labor and Mat'l. Report

19

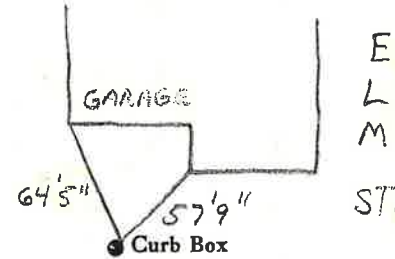

Main

Elev. of

Main at tap

Gate at ●

● Gate at

● Curb Box