

LABOR AND MATERIALS


1	Copper	Connection	7/4	\$
1	Curb	Cock Valve T. S. & V.	3/4 in. orifice	\$1
1	Service box	Short 3 1/2 x 4 1/2		
	Old returned	Long 4 1/2 x 5 1/2		
		Buff. or Rdway		\$
14	Ft. 3/4 in.	Copper G.I. G.I.	Pipe at	\$
	Nipples	in. at		\$
	Bushings	to in. at		\$
	Red'g			
	Inc'g	Coupl'gs. to in. at		\$
	Union	in. at		\$
	Meter	in. at		\$
	Lead Joints	at		\$
	Compound Joints	at		\$
	Maintenance Foreman			\$
	Hrs. Water Maint. Man-1	at		\$
	Hrs. Water Maint. Man-2	at		\$
	Hrs. Garage Foreman	at		\$
	Hrs. Labor	at		\$
	Hrs. Compressor	at		\$
	Compensation Ins. at \$	per C		\$
	Trucking			\$
	Pav't Patch			\$
	TAP BY Beecher & Co			\$
	Feb 18-1976			\$
	O'head			\$

PARK

St. Ave. No. 9

Name of Owner
R. J. Landry

Labor and Mat'l. Report Feb. 18 1976

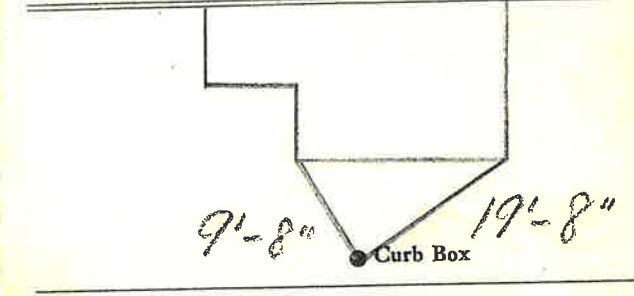

8" Main Elev. of Main at tap 5'

Gate at Gate at

RAEED
2014
REMOVES SERVICE FROM MAIN