


LABOR AND MATERIALS

Copper	} Connection		\$
Lead			
Curb	} Clock Valve T. S. & V. } in.	\$
Service box		} Short 3 1/2 X 4 1/2 }	
Old returned	Long 4 1/2 X 5 1/2 }		\$
	Buff or Rdway }		
Ft.	} Copper Galv. Iron Cast Iron }	Pipe at	\$
..... in.			
Nipples in. at		\$
Bushings to	in. at	\$
Red'g Inc'g	} Couplings to	\$
			in. at
Union in. at		\$
Meter in. at		\$
Lead Joints at			\$
Compound Joints at			\$
Hrs. Foreman at			\$
Hrs. Chauffeur at			\$
Hrs. Tapper at			\$
Hrs. Labor at			\$
Hrs. Labor at			\$
Hrs. Compressor at			\$
Compensation Ins.			\$
Trucking			\$
Builders Use of Water			\$
Waxsunski & Co			\$
			\$
			\$
			\$
			\$

St. _____
Pl. _____
Ave. No. 4749

Park
Name of Owner _____

Labor and Mat'l. Report July 1945

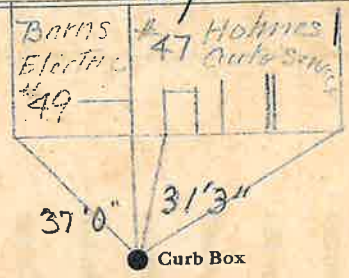

..... Main Elev. of Main at tap.....

Gate at ● ● Gate at

● Curb Box