


LABOR AND MATERIALS

Copper	}	Connection	\$	
Lead				
Curb	}	Cock	in.	\$
		Valve		
		T. S. & V.		
Service box	}	Short 3 1/2 x 4 1/2	\$	
Old returned		Long 4 1/2 x 5 1/2		
		Buff or Rdway		
16 Ft. 2" in.	}	Copper	Pipe at	\$
		G. I.		
		C. I.		
Nipples	in. at		\$	
Bushings	to in. at		\$	
Red'g	}	Coupl'gs	to in. at	\$
Inc'g				
Union	in. at		\$	
Meter	in. at		\$	
Lead Joints	at		\$	
Compound Joints	at		\$	
Maintenance Foreman			\$	
Hrs. Water Maint. Man	1 at		\$	
Hrs. Water Maint. Man	2 at		\$	
Hrs. Garage Foreman	at		\$	
Hrs. Labor	at		\$	
Hrs. Compressor	at		\$	
Compensation Ins.	at \$	per C	\$	
Trucking			\$	
Pav't Patch			\$	
			\$	
			\$	
O'head			\$	
			\$	

PARK
Name of Owner

St.
Pl.
Ave. No. 51

Labor and Mat'l. Report 19

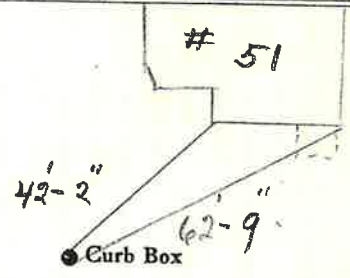

6" Main Elev. of Main at tap 4 1/2
 Gate at ● ● Gate at

● Curb Box