


Labor and Materials

Copper } Connection.....		\$
Lead }		\$
Curb } Cock Valve }	in.....	\$
	T. S. & V. }	\$
Service Box } Short 3/8x4 1/2 }		\$
Old returned } Long 1/2x5 1/2 }		\$
	Buff. or Rdway }	\$
2 1/2 Ft.....	in. } Copper Galv. Iron } Pipe at.....	\$
	Cast Iron }	\$
Nipples.....	in. at.....	\$
Bushings.....	to..... in. at.....	\$
Red'g } Couplings.....	to..... in. at.....	\$
Inc'g }		\$
Union.....	in. at.....	\$
Meter.....	in. at.....	\$
Lbs. Br. Stone at.....		\$
Lbs. Sand at.....		\$
Bags Cement at.....		\$
Paving Brick } Mack } at.....		\$
	Red }	\$
	Asphalt }	\$
Lead Joints at.....		\$
Leadite Joints at.....		\$
Hrs. Foreman at.....		\$
Hrs. Common Labor at.....		\$
Hrs. Common Labor at.....		\$
Hrs. Mason at.....		\$
Hrs. Mason's Helper at.....		\$
Hrs. Compressor at.....		\$
Compensation Ins.....		\$
Trucking.....		\$ 1.-
Builders' Use of Water.....		\$
Total \$.....		

30-70

Labor and Material Report

19

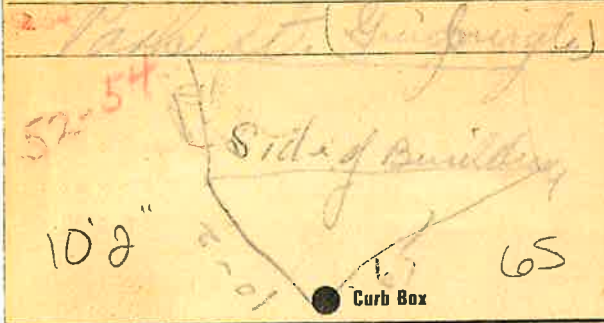

Main Elev of Main at tap

Gate at ● ● Gate at

● Curb Box

36
30
32
34

*Guishung Blag.
New Blag.*

Labor and Materials

Lead Connection	\$.
Curb Cock	\$.
1 Service Box (Short 3 1/2 x 4 1/2)	\$ 6.99
Old returned (Long 4 1/2 x 6 1/2)	
1 1/2 Ft. 4" in. G. I. Pipe at	\$ 1.29
Nipples in. at	\$
Bushings to in. at	\$
Red'g Coup to in. at	\$
Inc'g Coup to in. at	\$
Union in. at	\$
Meter in. at	\$
Cu. Yds. Br. Stone at	\$
Cu. Yds. Sand at	\$
Bags Cement at	\$
Paving Brick { Mack Red Asphalt } at	\$
9 Hrs. Foreman at	\$ 5.63
2.0 Hrs. Common Labor at	\$ 7.13
Hrs. Mason at	\$
Hrs. at	\$
Hrs. at	\$
Builders' Use of Water	\$
1-3/4" Taping Slacks at	\$ 1.35
1-5/8" Plug at	\$ 1.40
2-2" joint fluid at	\$ 1.30
2-6" " at	\$
Total	\$ 69.42

Labor and Material Report Sept 15 1923

4" Tap Dawley on Park St
 Glen Sup. Co.
 House Piped
 41' 3"
 42' 0"
 63' 9"
 Curb Box

6" Main Elev. of Main at tap 7 1/2
 Gate at ● Gate at ●

● Curb Box

Labor and Materials

1	Copper } Connection		\$
	Lead		
1	Curb } Cock Valve	1" in.	\$
	Service Box } Short 3 1/2 x 4 1/2		\$
	Old returned } Long 4 1/2 x 5 1/2		\$
		Buff. or Rdway	
21	Ft. 1" in. } Copper		\$
		Galv. Iron	
		Cast-Iron	
		Pipe at	
	Nipples	in. at	\$
	Bushings	to in. at	\$
	Red'g } Couplings	to in. at	\$
	Inc'g		
	Union	in. at	\$
	Meter	in. at	\$
	Lbs. Br. Stone	at	\$
	Lbs. Sand	at	\$
	Bags Cement	at	\$
	Paving Brick } Mack		\$
		Red	
		Asphalt	
	Lead Joints	at	\$
	Leadite Joints	at	\$
	Hrs. Foreman	at	\$
	Hrs. Common Labor	at	\$
	Hrs. Common Labor	at	\$
	Hrs. Mason	at	\$
	Hrs. Mason's Helper	at	\$
	Hrs. Compressor	at	\$
	Compensation Ins		\$
	Trucking		\$
	Builders' Use of Water		\$
	Total	\$	

Labor and Material Report July 14 1930

1" tap at 26 Park (Hinsburg)



(No Measurement)

● Curb Box

New tap

4" main run in on Park Ave No 1

4" Main

Elev of Main at tap 5

Gate at ●

● Gate at

● Curb Box

2-12 ft lengths 4"

3-lead joints 4"

1-4" Plug