

LABOR AND MATERIALS

1	Copper Lead	Connection	3/4"		\$
1	Curb	Cock Valve T.S. & V.	3/4 in.		\$
1	Service box Old returned	Short 3 1/2 x 4 1/2 Long 4 1/2 x 5 1/2 Buff or Rdway			\$
26	Ft.	3/4 in. { Copper G. I. C. I.	Pipe at		\$
	Nipples	in. at			\$
	Bushings	to in. at			\$
	Red'g Inc'g	Coupl'gs to in. at			\$
	Union	in. at			\$
	Meter	in. at			\$
	Lead Joints	at			\$
	Compound Joints	at			\$
	Maintenance Foreman				\$
	Hrs. Water Maint. Man-1	at			\$
	Hrs. Water Maint. Man-2	at			\$
	Hrs. Garage Foreman	at			\$
	Hrs. Labor	at			\$
	Hrs. Compressor	at			\$
	Compensation Ins.	at \$ per C			\$
	Trucking				\$
	Pav't Patch				\$
	Tap by Giggord +				\$
	Co. 9-22-59				\$
	O'head				\$
					\$

St. _____
 -Pl: _____
 Ave. No. 83

Park

Name of Owner
Dr. R. C. Batt.

Labor and Mat'l. Report Sept. 22 1959

83

48' 8"

33' 9"

● Curb Box

6" Main

Gate at ●

Elev. of
Main at tap 5'

● Gate at

● Curb Box

LSM-5C-2-5 56

LABOR AND MATERIALS

Copper	} Connection _____	\$ _____			
Lead					
Curb	} Cock Valve T. S. & V. }	in. _____ \$ _____			
			Service box	} Short 3½ x 4½ Long 4½ x 5½ Buff or Rdway }	\$ _____
Ft. _____	in. { Copper G. I. C. I. }	Pipe at _____ \$ _____			
Nipples	in. at _____	\$ _____			
Bushings	to _____ in. at _____	\$ _____			
Red'g Inc'g	} Coupl'gs _____ to _____ in. at _____	\$ _____			
Union			in. at _____		
Meter	in. at _____	\$ _____			
Lead Joints	at _____	\$ _____			
Compound Joints	at _____	\$ _____			
Maintenance Foreman	_____	\$ _____			
Hrs. Water Maint. Man-1	at _____	\$ _____			
Hrs. Water Maint. Man-2	at _____	\$ _____			
Hrs. Garage Foreman	at _____	\$ _____			
Hrs. Labor	at _____	\$ _____			
Hrs. Compressor	at _____	\$ _____			
Compensation Ins. at \$ _____	per C _____	\$ _____			
Trucking	_____	\$ _____			
Pav't Patch	_____	\$ _____			
_____	_____	\$ _____			
_____	_____	\$ _____			
O'head	_____	\$ _____			

Remerwell 11-26-80

St. { 83 }
Pl. { 85 }
Ave. No. _____


PARK

Name of Owner _____

Richard C. Bates n.o.

Labor and Mat'l. Report _____

19 80

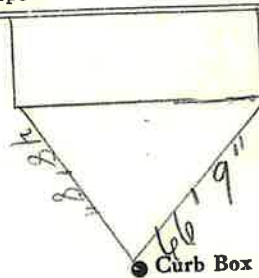

6" Main

Elev. of
Main at tap 5'

Gate at •

• Gate at

• Curb Box