

LABOR AND MATERIALS


Copper	} Connection	_____	\$ _____		
Lead					
Curb	} Cook Valve T. S. & V.	} _____ in.	\$ _____		
				} Service box	} Short 3½ x 4½
		} Buff or Rdway	\$ _____		
Ft. _____ in.	} Copper G. I. C. I.	} Pipe at _____	\$ _____		
				Nipples _____ in. at _____	\$ _____
				Bushings _____ to _____ in. at _____	\$ _____
Red'g } Inc'g	} Coupl'gs _____ to _____ in. at _____	\$ _____	\$ _____		
Union _____ in. at _____				\$ _____	
Meter _____ in. at _____	\$ _____	\$ _____	\$ _____		
Lead Joints at _____	\$ _____	\$ _____	\$ _____		
Compound Joints at _____	\$ _____	\$ _____	\$ _____		
Maintenance Foreman _____	\$ _____	\$ _____	\$ _____		
Hrs. Water Maint. Man—1 at _____	\$ _____	\$ _____	\$ _____		
Hrs. Water Maint. Man—2 at _____	\$ _____	\$ _____	\$ _____		
Hrs. Garage Foreman _____ at _____	\$ _____	\$ _____	\$ _____		
Hrs. Labor _____ at _____	\$ _____	\$ _____	\$ _____		
Hrs. Compressor at _____	\$ _____	\$ _____	\$ _____		
Compensation Ins. at \$ _____ per C _____	\$ _____	\$ _____	\$ _____		
Trucking _____	\$ _____	\$ _____	\$ _____		
Pav't Patch _____	\$ _____	\$ _____	\$ _____		
_____	\$ _____	\$ _____	\$ _____		
_____	\$ _____	\$ _____	\$ _____		
O'head _____	\$ _____	\$ _____	\$ _____		
_____	\$ _____	\$ _____	\$ _____		

PARK

St. ~~Pl.~~ Ave. No. **85**

Name of Owner _____

Labor and Mat'l. Report 19

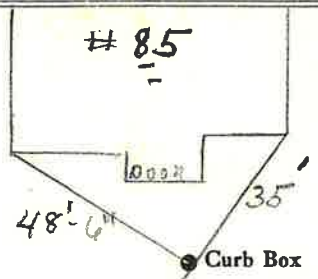

Main	Elev. of Main at tap _____
Gate at ●	● Gate at

● Curb Box

38-115

St. Park
Pl. Ave. No. 85

Name of Owner
Garston

Labor and Mat'l. Report Oct 30 1945

St. Park
Pl. Ave. No. 85

Name of Owner
Garston

Labor and Mat'l. Report Oct 30 1945

38-115

St. Park
Pl. Ave. No. 85

Name of Owner
Garston

Labor and Mat'l. Report Oct 30 1945

St. Park
Pl. Ave. No. 85

Name of Owner
Garston

Labor and Mat'l. Report Oct 30 1945

