

LABOR AND MATERIALS


Copper	Lead	Connection	3/4	\$	2.94
Curb	Cock Valve		3/4 in.	\$	3.71
Service box	Short 3 1/2 X 4 1/2			\$	
Old returned	Long 4 1/2 X 5 1/2	same		\$	
25 Ft.	3/4 in.	Copper Pipe at	30	\$	7.50
		G. I.		\$	
		C. I.		\$	
Nipples	in.	at		\$	
Bushings	to	in.	at	\$	
Red'g				\$	
Inc'g	Coupl'gs	to	in.	at	\$
Union	in.	at		\$	
Meter	in.	at		\$	
Lead Joints	at			\$	
Compound Joints	at			\$	
4	Hrs. Water Maint. Man-1	at	1.01	\$	4.04
10	Hrs. Water Maint. Man-2	at	.91	\$	9.10
9	Hrs. Labor	at	.80	\$	7.20
	Hrs. Labor	at		\$	
2	Hrs. Compressor at		1.20	\$	2.40
	Compensation Ins. at	\$		per C	.45
	Trucking			\$	1.00
	Pav't Patch			\$	9.20
	Tap by Muller			\$	
	O'head			\$	
				\$	47.54

73

St. _____
Pl. _____
Ave. No. 87

Name of Owner
Girard

Labor and Mat'l. Report June 16 1918

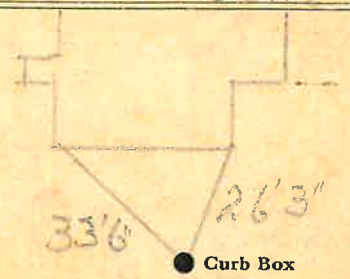

Main Elev. of Main at tap

Gate at ● ● Gate at

● Curb Box