




Labor and Material Report *Sept 12* 1923

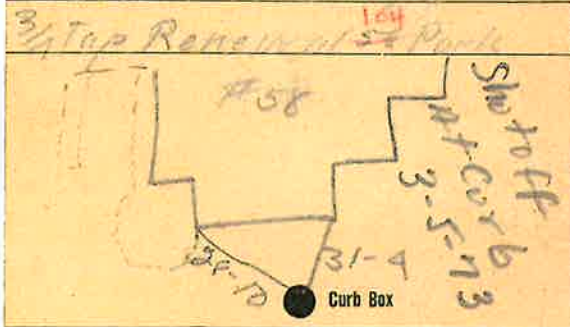

6" Main Elev. of Main at tap *4 1/2*

Gate at ● ● Gate at

● Curb Box

3/4" Renewal Tap. 10-4-62.

Labor and Materials

1	Lead Connection	3/4	\$
1	Curb Cock	1 1/4	\$
1	Service Box	{ Short 3 1/2 x 4 1/2 Long 4 1/2 x 5 1/2 Buffalo	\$
	Old returned		
1.0	Ft. 3/4 in. G. I. Pipe at		\$
	Nipples	in. at	\$
	Bushings	to in. at	\$
	Red'g Coup	to in. at	\$
	Inc'g Coup	to in. at	\$
	Union	in. at	\$
	Meter	in. at	\$
	Cu. Yds. Br. Stone at		\$
	Cu. Yds. Sand at		\$
	Bags Cement at		\$
	Paving Brick	{ Mack Red Asphalt }	at \$
7	Hrs. Foreman at		
15	Hrs. Common Labor at		
	Hrs. Mason at		\$
	Hrs.	at	\$
	Hrs.	at	\$
2.0	Builders' Use of Water		\$
		at	\$
	<i>7. Truck load</i>	at	\$
		at	\$
		at	\$
		at	\$