


Labor and Material Report

Sept 15 - 1923

3/4 Tap Replaced at 60+6 1/2 Park

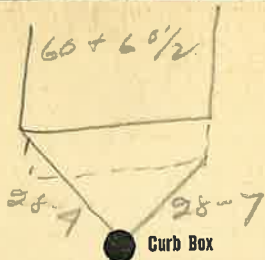

6" Main

Elev. of Main at tap 44

Gate at ●

● Gate at

● Curb Box

166

Park

St.

Pl. →

Ave. No. 106

Name of Owner


Johnson

Labor and Mat'l. Report

Nov 30

1948

House To Be Razed

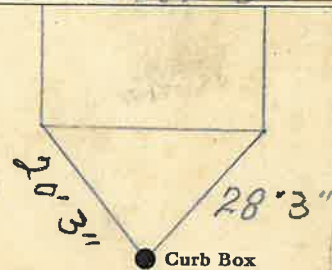

6" Main

Elev. of Main at tap 5

Gate at ●

● Gate at

● Curb Box

Shut off at Curb

Oct-23-1974

