

Labor and Materials

1	Copper	} Connection ^{3/4"}		\$ 1.50	
1	Lead				
1	Curb	} Cock Valve T.S.&V. } .3/4" in		\$ 1.70	
1	Service Box		} Short 3 1/2 x 4 1/2 } } Long 4 1/2 x 5 1/2 } } Buff. or Rdway }		\$ 1.44
7	Ft.	} in. } } Galv. Iron } } Cast Iron }		Pipe at	\$ 1.71
1	Nipples		} 1/2" in. at all		\$ 0.05
	Bushings	to		in. at	\$
	Red'g Inc'g	} Couplings	to	in. at	\$
	Union		in. at		\$
	Meter	in. at		\$	
	Lbs. Br. Stone	at		\$	
	Lbs. Sand	at		\$	
	Bags Cement	at		\$	
	Paving Brick	} Mack } } Red } } Asphalt }	at	\$	
	Lead Joints		at		\$
	Leadite Joints	at		\$	
14	Hrs. Foreman	^{F.V.C.} at	^{6 1/2 hr}	\$ 8.75	
10	Hrs. Common Labor	at	⁵⁰	\$ 5.00	
	Hrs. Common Labor	at		\$	
	Hrs. Mason	at		\$	
	Hrs. Masons Helper	at		\$	
	Hrs. Compressor	at		\$	
	Compensation Ins			\$ 0.49	
	Trucking			\$ 2.00	
	Builders Use of Water			\$	
Total				\$ 22.64	


5 34

Labor and Material Report

Apr 14

1930

3. T. 1/2" pipe 10 Parts 1/2

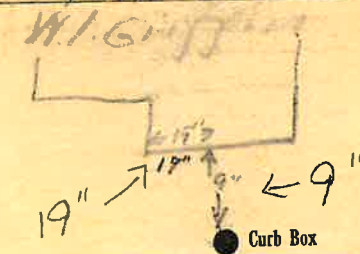

6 Main

Elev. of Main at top 444

Gate at ●

● Gate at

● Curb Box

old top sheet off

[Handwritten signature]

[Handwritten mark]


Labor and Materials

1	Copper	Connection	3	\$ 3.20
1	Lead		1	
1	Curb	Cock Valve T.S. & V.	3	\$ 1.00
1	Service Box	Short 3 1/2 x 4 1/2		\$ 1.30
	Old returned	Long 4 1/2 x 3 1/2		
		Butt or Red way		
37	Ft.	Copper Galv. Iron Cast Iron	3	\$ 8.14
		Pipe at	4	
	Nipples	in. at		\$
	Bushings	to in. at		\$
	Red'g Inc'g	Couplings to in. at		\$
	Union	in. at		\$
	Meter	in. at		\$
	Lbs. Br. Stone	at		\$
	Lbs. Sand	at		\$
	Bags Cement	at		\$
	Paving Brick	Mack Red Asphalt at		\$
	Lead Joints	at		\$
	Leadite Joints	at		\$
2	Hrs. Foreman	at	1.25	\$ 1.25
	Hrs. Common Labor	at		\$
	Hrs. Common Labor	at		\$
	Hrs. Mason	at		\$
	Hrs. Mason's Helper	at		\$
	Hrs. Compressor	at		\$
	Compensation Ins		04	\$.04
	Trucking		1.00	\$ 1.00
	Builders' Use of Water			\$
Total				\$ 15.93

Labor and Material Report

July 21 1925

Rear of 10 Park St

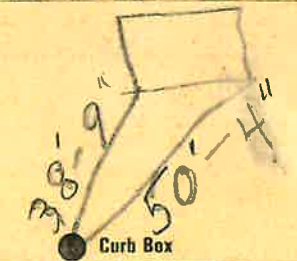

New Garage

6 Main Elev of Main at tap 4 1/2

Gate at Gate at

Curb Box

Milford Comps
Rear 10 1/2 Park