

Labor and Material Report *Sept 14* 19 *60*

1/2" Top 18 Curb to Park St



6" Main Elev. of Main at tap *4 1/2*

Gate at ● Gate at ●

● Curb Box


Park

St. Pl. Ave. No. *109*

Name of Owner

O'Keefe

Labor and Mat'l. Report *June 16* 19 *60*

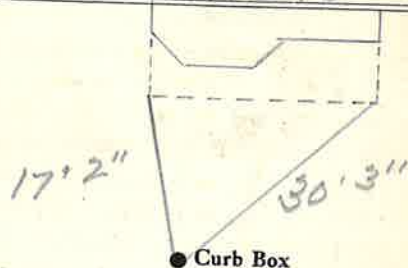

6" Main

Elev. of Main at tap *5'*

Gate at ● Gate at ●

● Curb Box

*Shut off at Curb
NOV-17-1975*

Labor and Materials

1 Lead Connection $\frac{1}{2}$ \$
 1 Curb Cock $\frac{3}{4}$ \$
 1 Service Box (Short $3\frac{1}{2}$ x $4\frac{1}{2}$
 Old returned (Long $4\frac{1}{2}$ x $5\frac{1}{2}$
 Buffalo) \$
 26 Ft. $\frac{3}{4}$ in. C.I. Pipe at \$
 Nipples in. at \$
 Bushings to in. at \$
 Red'g Coupl'gs to in. at \$
 Inc'g Coupl'gs to in. at \$
 Union in. at \$
 Meter in. at \$
 Cu. Yds. Br. Stone at \$
 Cu. Yds. Sand at \$
 Bags Cement at \$
 Paving Brick { Mack
 Red
 Asphalt } \$
 3 Hrs. Foreman at \$
 12 Hrs. Common Labor at \$
 Hrs. Mason at \$
 Hrs. at \$
 Hrs. at \$
 9.5 Builders' Use of Water \$
 at \$
 at \$
 at \$
 Total \$ 157.44

LABOR AND MATERIALS

1 Copper } Connection $\frac{3}{4}$ " \$
 Lead }
 1 Curb } Cock \$
 Valve } $\frac{3}{4}$ in.
 T. S. & V. }
 1 Service box { Short $3\frac{1}{2}$ x $4\frac{1}{2}$
 Old returned { Long $4\frac{1}{2}$ x $5\frac{1}{2}$
 Buff or Rdway } \$
 28 Ft. $\frac{3}{4}$ in. { Copper } Pipe at \$
 C.I. }
 C.I. }
 Nipples in. at \$
 Bushings to in. at \$
 Red'g } Coupl'gs to in. at \$
 Inc'g }
 Union in. at \$
 Meter in. at \$
 Lead Joints at \$
 Compound Joints at \$
 Maintenance Foreman \$
 Hrs. Water Maint. Man-1 at \$
 Hrs. Water Maint. Man-2 at \$
 Hrs. Garage Foreman at \$
 Hrs. Labor at \$
 Hrs. Compressor at \$
 Compensation Ins. at \$ per C \$
 Trucking \$
 Pav't Patch \$
 Tap by Giggord & Co \$
 6-16-60. \$
 O'head \$

7-29-66
109 Park St.

Shut off at curb

7-28-66

by Gifford & Co.

OWNER

G.F. Hospital