

LABOR AND MATERIALS

Copper	Connection	\$
Lead		\$
Curb	Cock	in. \$
	Valve	
	T. S. & V.	
Service box	Short 3 1/2 x 4 1/2	\$
Old returned	Long 4 1/2 x 5 1/2	
	Buff or Rdway	
21 Ft. 6 in.	Copper	Pipe at \$
	G. I.	
	C. I.	
Nipples	in. at	\$
Bushings	to in. at	\$
Red'g		\$
Inc'g	Coupl'gs to in. at	
Union	in. at	\$
Meter	in. at	\$
Lead Joints at		\$
Compound Joints at		\$
Maintenance Foreman		\$
Hrs. Water Maint. Man—1 at		\$
Hrs. Water Maint. Man—2 at		\$
Hrs. Garage Foreman at		\$
Hrs. Labor— at		\$
Hrs. Compressor at		\$
Compensation Ins. at \$ per C.		\$
Trucking		\$
Pay't Patch		\$
3 Hecce 6" Cast Iron pipe		\$
With Balls 9" 8" 4"		\$
2-8" Lead joints 3 Balls		\$
O'head		\$
		\$

Park Street St. Pl. Ave. No. 12014

Name of Owner
Greenfalls Post Co.

6" Sprinkler System Tap

Labor and Mat'l. Report Aug 3 to 7 1959

32'8" 44"

Large Roadway Box

● Curb Box

gutter Main Elev. of Main at tap 5' 1/2"

Gate at ● Gate at

21' to main

● Curb Box

6" Tap.

#10 14 TAX 10# 310.5-1-17

LSM-SC-2-5 58

LABOR AND MATERIALS


Copper / Lead	Connection	3/4	\$	2.87
Curb	Cock Valve T. S. & V.	3/4 in.	\$	3.62
Service box	Short 3 1/2 X 4 1/2			
Old returned	Long 4 1/2 X 5 1/2			
	Buff or Rdway		\$	4.68
8 Ft.	3/4 in. Copper	Pipe at 3/4	\$	2.56
	G. I.			
	C. I.			
Nipples	in. at		\$	
Bushings	to in. at		\$	
Red'g			\$	
Inc'g	Coupl'gs to in. at		\$	
Union	in. at		\$	
Meter	in. at		\$	
Lead Joints	at		\$	
Compound Joints	at		\$	
2 Hrs. Water Maint. Man-1	at 1.12	\$	2.24	
2 Hrs. Water Maint. Man-2	at 1.02	\$	2.04	
8 Hrs. Labor	at 91	\$	7.28	
Hrs. Labor	at	\$		
2 Hrs. Compressor	at 1.70	\$	3.40	
Compensation Ins.	at \$ 2.18 per C	\$	1.39	
Trucking		\$	2.00	
Pav't Patch		\$	14.85	
Taylor		\$		
O'head		\$		
		\$	51.05	

3

St. 12-14
 Pt. Ave. No.

Name of Owner
 Post Star

Labor and Mat'l. Report Dec 6 19 41

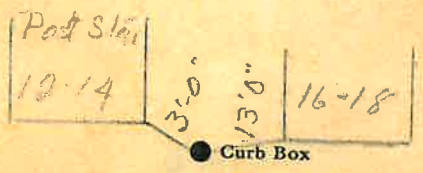

6 Main Elev. of Main at tap 5
 Gate at ● Gate at ●

8' to main

● Curb Box

3/4" Tap.

LSM-5C 5 15-48

Old top dug up + shot off


Labor and Materials

1	Copper	Connection	3/4"	\$	3.20
1	Curb	Cock Valve	2 in.	\$	1.00
1	Service Box	Short 3 1/2 x 4 1/2		\$	1.30
	Old returned	Long 4 1/2 x 5 1/2		\$	
35	Ft.	3/4 in.	Copper Galv. Iron Cast Iron	Pipe at	7.70
	Nipples			in. at	\$
	Bushings			to in. at	\$
1	Red'g	Couplings	3/4"	to in. at	\$ 1.15
	Union			in. at	\$
	Meter			in. at	\$
	Lbs. Br. Stone	at			\$
	Lbs. Sand	at			\$
	Bags Cement	at			\$
	Paving Brick	Mack Red Asphalt		at	\$
	Lead Joints	at			\$
	Leadite Joints	at			\$
2	Hrs. Foreman	at			\$ 1.25
2	Hrs. Common Labor	at			\$.81
	Hrs. Common Labor	at			\$
	Hrs. Mason	at			\$
	Hrs. Mason's Helper	at			\$
	Hrs. Compressor	at			\$
	Compensation Ins.				\$.05
	Trucking				\$ 1.00
	Builders' Use of Water				\$ 3.00
				Total	\$ 19.46

Park St - rear
Wyatt Ellsworth

Labor and Material Report 17-18 19 25

New Building by Sawyer

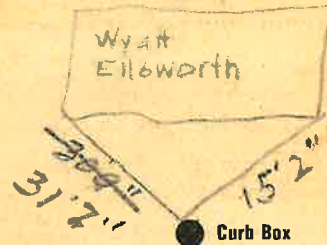

Park St by Sawyer

6' Main Elev. of Main at tap 5'
Gate at ● Gate at ●

● Curb Box

New Tap to new
Building
No Cover on Curb Box
Brown off.