


LABOR AND MATERIALS

Copper } Connection _____	\$ _____
Lead } _____	
Curb } Cock _____	\$ _____
} Valve _____	in. _____
} T. S. & V. _____	
Service box { Short 3½ x 4½ _____	\$ _____
Old returned { Long 4½ x 5½ _____	
} Buff or Rdway _____	
Ft. <u>4</u> in. { Copper _____	\$ _____
} G. I. _____	
} C. I. _____	
} Pipe at _____	
Nipples _____ in. at _____	\$ _____
Bushings _____ to _____ in. at _____	\$ _____
Red'g } _____	\$ _____
Inc'g } Coupl'gs _____ to _____ in. at _____	
Union _____ in. at _____	\$ _____
Meter _____ in. at _____	\$ _____
Lead Joints at _____	\$ _____
Compound Joints at _____	\$ _____
Maintenance Foreman _____	\$ _____
Hrs. Water Maint. Man—1 at _____	\$ _____
Hrs. Water Maint. Man—2 at _____	\$ _____
Hrs. Garage Foreman _____ at _____	\$ _____
Hrs. Labor— _____ at _____	\$ _____
Hrs. Compressor at _____	\$ _____
Compensation Ins. at \$ _____ per C _____	\$ _____
Trucking _____	\$ _____
Pav't Patch _____	\$ _____
_____	\$ _____
_____	\$ _____
O'head _____	\$ _____
_____	\$ _____

St. _____
-Pl- _____
Ave. No. 2

Name of Owner _____

Labor and Mat'l. Report Feb 1987

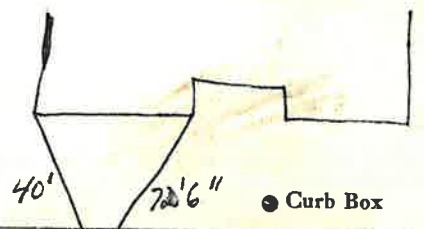

Main Elev. of
Main at tap _____

Gate at ● ● Gate at _____

● Curb Box