


LABOR AND MATERIALS

1 Copper } Connection 1 1/2" \$  
 1 Curb } Cock Valve } 1 1/2 in. (briseal) \$  
           } T. S. & V. }  
 1 Service box } Sheet 3 1/2 x 4 1/2 }  
 Old returned } Long 4 1/2 x 3 1/2 }  
                   } Half or Rdway } \$  
 16 Ft. 1 1/2 in. } Copper } Pipe at \$  
                   } C.I. }  
                   } CR }  
 Nipples \_\_\_\_\_ in. at \$  
 Bushings \_\_\_\_\_ to \_\_\_\_\_ in. at \$  
 Red'g }  
 Inc'g } Coupl'gs \_\_\_\_\_ to \_\_\_\_\_ in. at \$  
 Union \_\_\_\_\_ in. at \$  
 Meter \_\_\_\_\_ in. at \$  
 Lead Joints at \$  
 Compound Joints at \$  
 Maintenance Foreman \_\_\_\_\_ \$  
 Hrs. Water Maint. Man-1 at \$  
 Hrs. Water Maint. Man-2 at \$  
 Hrs. Garage Foreman \_\_\_\_\_ at \$  
 Hrs. Labor \_\_\_\_\_ at \$  
 Hrs. Compressor at \$  
 Compensation Ins. at \$ \_\_\_\_\_ per C \$  
 Trucking \_\_\_\_\_ \$  
 Pav't Patch \_\_\_\_\_ \$  
 Tap made by Beecher & Co \_\_\_\_\_ \$  
 O'head MAY-7-1974 \$  
 \_\_\_\_\_ \$  
 \_\_\_\_\_ \$

Parker St. 7  
 Ave. No. 7  
 Name of Owner  
Glens Falls Cemetery  
 Labor and Mat'l. Report MAY 7 1974

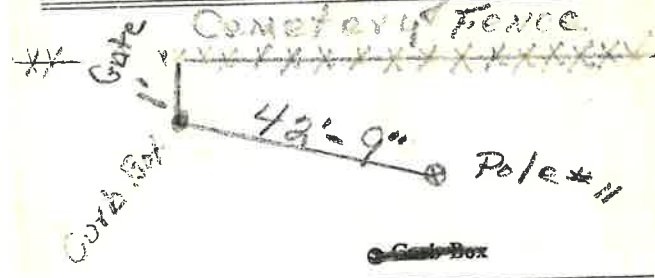

6" Main Elev. of Main at tap 3'  
 Gate at • Gate at •  
 Curb Box  
 ✓

LSM-5C-6-1-67  
 Use long wrench