

LABOR AND MATERIALS


1 Copper } 1 1/2" x 3/4" Tee
 Lead } Connection \$
 1 Curb } Cock } 3/4" or 1 seat
 Valve } in. \$
 F.S. & V. }
 1 Service box } Short 3 1/2 x 4 1/2
 Old returned } Long 4 1/2 x 5 1/2
 Buff or Rdway } \$
 29 Ft. 3/4 in. } Copper } Pipe at \$
 G.I. }
 G.I. }
 1 Nipples 3/4 in. at 3" Brass \$
 Bushings to in. at \$
 1 Red's } 3/4" 1" on to iron stop
 Inc's } Coupl'gs to in. at \$
 1 Union 3/4 in. at male adapter \$
 Meter in. at \$
 Lead Joints at \$
 Compound Joints at \$
 Maintenance Foreman \$
 Hrs. Water Maint. Man-1 at \$
 Hrs. Water Maint. Man-2 at \$
 Hrs. Garage Foreman at \$
 Hrs. Labor at \$
 Hrs. Compressor at \$
 Compensation Ins. at \$ per C \$
 Trucking \$
 Pav't Patch \$
 Tap by Gifford & Kelly \$
 3-26-64 \$
 O'head \$

Dr.
 -Str
 Pl-
 Ave. No. 3

Patten

Name of Owner Kelly Bros.

Labor and Mat'l. Report Mar. 26 1964

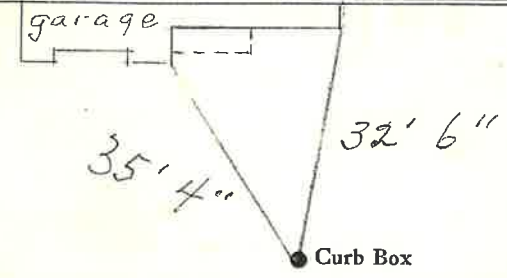

1 1/2" Copper Elev. of Main at tap 5'

Gate at • Gate at

• Curb Box