

LABOR AND MATERIALS


1 Copper } 1 1/2 x 1/4 Brass Tee
 Lead } Connection \$
 1 Curb } Cock } 3/4 in. O-ring seal
 Valve } \$
 T.S. & V. }
 1 Service box } Short 3 1/2 x 4 1/2
 Old returned } Long 4 1/2 x 5 1/2 }
 Buff or Rdway } \$
 18 Ft. 3/4 in. } Copper } Pipe at \$
 G.I. }
 G.I. } 3" B1-055
 1 Nipples 3/4 in. at \$
 1 Bushings 3/4 in. to 3/4 in. at \$
 Red's } 3/4" + 1/2" Male Adapter
 Inc's } Coupl'gs to in. at \$
 1 Union 3/4 in. at 1" on to 1 1/2" stop
 Meter in. at \$
 Lead Joints at \$
 Compound Joints at \$
 Maintenance Foreman \$
 Hrs. Water Maint. Man-1 at \$
 Hrs. Water Maint. Man-2 at \$
 Hrs. Garage Foreman at \$
 Hrs. Labor at \$
 Hrs. Compressor at \$
 Compensation Ins. at \$ per C \$
 Trucking \$
 Pav't Patch \$
 Tap by Gifford & Kelly \$
 3-26-64. \$
 O'head \$

Dr. 7?
 St.
 Pl.
 Ave. No. (2)

Patton

Name of Owner Kelly Bros.

Labor and Mat'l. Report Mar. 26 1964

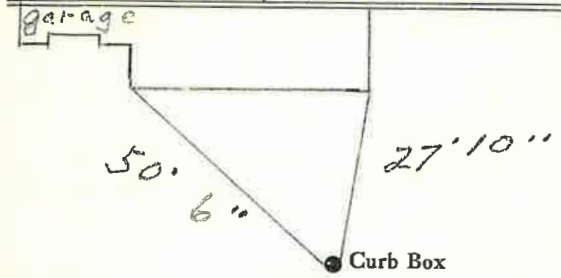

1 1/2" Copper Main Elev. of Main at tap 5'
 Gate at • Gate at •

• Curb Box

7 Patton
 TAX ID #
 302.12-5-1