

LABOR AND MATERIALS


1 Copper } Connection _____ \$
 Lead }
 1 Curb } Cock } 3/4 in. } 0-1 seat } \$
 } Valve }
 } T. S. & V. }
 1 Service box } { Short 3 1/2 x 4 1/2 }
 Old returned } { Long 4 1/2 x 5 1/2 }
 } { Buff or Rdway } _____ \$
 25 Ft. 3/4 in. } { Copper } Pipe at _____ \$
 } { G. I. }
 } { C. I. } 3" _____ \$
 1 Nipples 3/4 in. at _____ \$
 1 Bushings 1/4" to 3/4 in. at _____ \$
 1 Red'g } 3/4" stop at 15' 0" to 17' 0" }
 Jee'g } Coupl'gs to in. at _____ \$
 1 Union 3/4 in. at male Adapter _____ \$
 Meter in. at _____ \$
 Lead Joints at _____ \$
 Compound Joints at _____ \$
 Maintenance Foreman _____ \$
 Hrs. Water Maint. Man-1 at _____ \$
 Hrs. Water Maint. Man-2 at _____ \$
 Hrs. Garage Foreman at _____ \$
 Hrs. Labor at _____ \$
 Hrs. Compressor at _____ \$
 Compensation Ins. at \$ _____ per C _____ \$
 Trucking _____ \$
 Pav't Patch _____ \$
 Tap by Gifford & Co. _____ \$
 3-275-64. _____ \$
 O'head _____ \$
 _____ \$

Dr. 87
 -St.
 -Pl.
 -Ave. No. ①

Patton

Name of Owner Kelly Bros.

Labor and Mat'l. Report Mar. 25 19 64

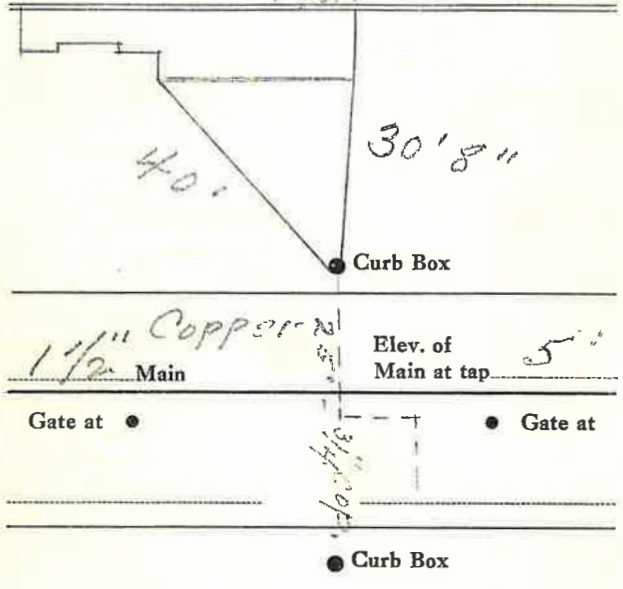

1 1/2" Copper Main Elev. of Main at tap 5'

Gate at • Gate at

8 Patton
 TAX ID #
 302.12-6-5