

LABOR AND MATERIALS


1 Copper } Connection 2" \$
 Lead }
 1 Curb } Cock } 2" Oriseal \$
 } Valve } in.
 } T.S. & V. }
 1 Service box } Short 3 1/2 x 4 1/2 } Oriseal \$
 Old returned } Long 4 1/2 x 5 1/2 } Curb box \$
 } Buff or Rdway }
 40 Ft. 2 in. } Copper } Pipe at \$
 } G.I. }
 } C.I. }
 Nipples in. at \$
 Bushings to in. at \$
 Red'g }
 Inc'g } Coupl'gs. to in. at \$
 Union in. at \$
 Meter in. at \$
 Lead Joints at \$
 Compound Joints at \$
 Maintenance Foreman \$
 Hrs. Water Maint. Man-1 at \$
 Hrs. Water Maint. Man-2 at \$
 Hrs. Garage Foreman at \$
 Hrs. Labor at \$
 Hrs. Compressor at \$
 Compensation Ins. at \$ per C \$
 Trucking \$
 Pav't Patch \$
 Tap by Lareau & Co. \$
 7-20-68 \$
 O'head \$

16 PEARL ST.

Pearl St. Ave. No.

Name of Owner
 Kamyr Inc.

Labor and Mat'l. Report July 20 19 68

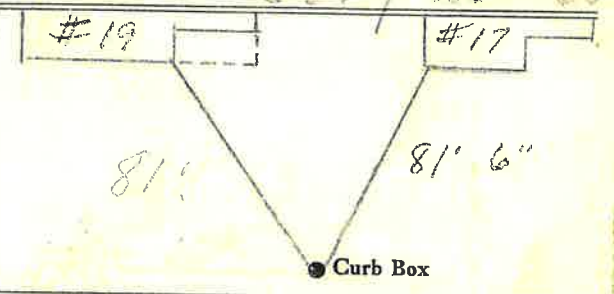

8" Main → Elev. of Main at tap 4-5'

Gate at • Gate at

TAX ID # 303.17-9-3.3

● Curb Box

2" Tap