

LABOR AND MATERIALS


Copper	} Connection	_____	\$		
Lead		_____	\$		
Curb	} Cock	_____ in.	\$		
				} Valve	_____
Service box	} Short 3½ x 4½	_____	\$		
				Old returned	} Long 4½ x 5½
24 Ft. 1½ in.	} Copper	_____	\$		
				} G.I.	} Pipe at
	} G.I.	_____	\$		
Nipples				_____ in. at	_____
Bushings	_____ to _____ in. at	_____	\$		
Red'g	} Coupl'gs	_____ to _____ in. at	\$		
Inc'g				_____	
Union	_____ in. at	_____	\$		
Meter	_____ in. at	_____	\$		
Compound Joints	_____ at	_____	\$		
Maintenance Foreman	_____ at	_____	\$		
Hrs. Water Maint. Man-1	_____ at	_____	\$		
Hrs. Water Maint. Man-2	_____ at	_____	\$		
Hrs. Garage Foreman	_____ at	_____	\$		
Hrs. Labor	_____ at	_____	\$		
Hrs. Compressor	_____ at	_____	\$		
Trucking	_____	_____	\$		
Pav't Patch	_____	_____	\$		
			\$		
			\$		
St. \_\_\_\_\_  
 Pl. \_\_\_\_\_  
 Ave. No. 1

*Reck*

Name of Owner *Walton*

Labor and Mat'l. Report *Oct 1987*

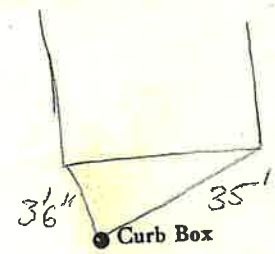

Main \_\_\_\_\_ Elev. of Main at tap \_\_\_\_\_

Gate at • \_\_\_\_\_ • Gate at \_\_\_\_\_

• Curb Box