

**Labor and Materials**

1	Copper } Connection	3/4	.....	\$ 3.20
	Lead } .....			
1	Curb { Cock } .....	3/4	in.	\$ 1.00
		Valve } .....		
		T.S. & V. } .....		
1	Service Box } Short 3 1/2 x 4 1/2		.....	\$ 1.30
	Old returned } Long 4 1/2 x 5 1/2		.....	
		Buff. or Rdway } .....		
9	Ft. 3/4 in. { Copper } Pipe at		.....	\$ 1.98
		Galv. Iron } .....		
		Cast Iron } .....		
	Nipples	.....	in. at	\$
	Bushings	.....	to ..... in. at	\$
	Red'g } Couplings	.....	to ..... in. at	\$
	Inc'g } .....			
	Union	.....	in. at	\$
	Meter	.....	in. at	\$
	Lbs. Br. Stone	.....	at	\$
	Lbs. Sand	.....	at	\$
	Bags Cement	.....	at	\$
	Paving Brick { Mack } at		.....	\$
		Red } .....		
		Asphalt } .....		
	Lead Joints	.....	at	\$
	Leadite Joints	.....	at	\$
1	Hrs. Foreman	.....	at	\$ 6.30
4	Hrs. Common Labor	.....	at	\$ 6.30
	Hrs. Common Labor	.....	at	\$
	Hrs. Mason	.....	at	\$
	Hrs. Mason's Helper	.....	at	\$
	Hrs. Compressor	.....	at	\$
	Compensation Ins.	.....		\$ .06
	Trucking	.....		\$ 0.00
	Builders' Use of Water	.....		\$
Total				\$ 10.80


28-170

**Labor and Material Report**

Dec 1.

1928

37 23 Beck Ave

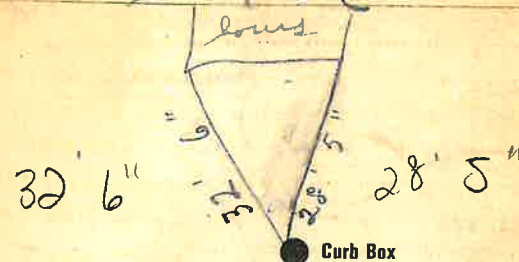

6" Main

Elev. of Main at tap 5'

Gate at ●

● Gate at

● Curb Box

Gabriel Cullen

TAX ID# 303.18-4-2.6