

LABOR AND MATERIALS


$\frac{3}{4}$ Copper } Connection _____ \$ _____
 } Cock
 Curb } Valve } _____ in. _____ \$ _____
 } T.S. & V. }
 Service box { Short 3-1/2 x 4-1/2 } _____ \$ _____
 Old returned { Long 4-1/2 x 5-1/2 }
 33 Ft. 7 in. { Copper } Pipe at _____ \$ _____
 } G.I.
 } C.I.
 Nipples _____ in. at _____ \$ _____
 Bushings _____ to _____ in. at _____ \$ _____
 Red'g _____
 Inc'g _____
 Union _____ in. at _____ \$ _____
 Meter _____ in. at _____ \$ _____
 _____ \$ _____
 Compound Joints at _____ \$ _____
 Maintenance Foreman _____ \$ _____
 Hrs. Water Maint. Man - 1 at _____ \$ _____
 Hrs. Water Maint. Man - 2 at _____ \$ _____
 Hrs. Garage Foreman _____ at _____ \$ _____
 Hrs. Labor _____ at _____ \$ _____
 Hrs. Compressor at _____ \$ _____
 _____ \$ _____
 Trucking _____ \$ _____
 Pav't Patch _____ \$ _____
 _____ \$ _____
 _____ \$ _____
 _____ \$ _____
 _____ \$ _____

PECK AVE ^{S.P.} Ave. No. 38

Name of Owner _____

Labor and Mat'l. Report #

5/2005

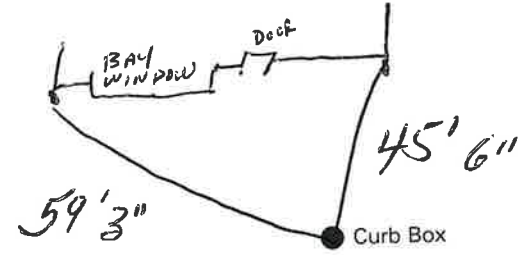

H₂O
 Elev. of Main at tap 5'

Gate at ●

● Gate at

SEWER MAIN @ 5'
 26' CURB TO MAIN SEWER

● Curb Box