


Labor and Materials

1	Copper	Connection	3	1.33
1	Curb	Cock Valve	3	1.58
1	Service Box	Short 2 1/2 x 4 1/2		1.36
	Old returned	Long 4 1/2 x 5 1/2		
12	Ft.	Copper Pipe	3	1.14
		Cast Iron	4	
	Nipples	in. at		
	Bushings	to in. at		
	Red'g Inc'g	Couplings to in. at		
	Union	in. at		
	Meter	in. at		
	Lbs. Br. Stone	at		
	Lbs. Sand	at		
	Bags Cement	at		
	Paving Brick	Mack Red Asphalt at		
	Lead Joints	at		
	Leadite Joints	at		
5	Hrs. Foreman	at		1.88
	Hrs. Common Labor	at		2.60
	Hrs. Common Labor	at		
	Hrs. Mason	at		
	Hrs. Masons Helper	at		
	Hrs. Compressor	at		
	Compensation Ins			1.17
	Trucking			
	Builders Use of Water	Patch		5-
Total				\$17.06

39 Park Ave (Jaylor)

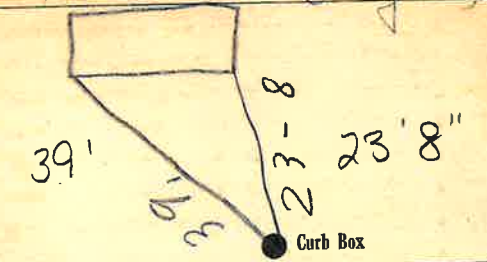

6 Main Elev. of Main at tap 5
 Gate at TAX 10 # 303.18.4.25 Gate at

● Curb Box
Shuts OFF Counter Clockwise
 New House

MD

m