


**Labor and Materials**

1	Copper	Connection	.....	\$ 3 20
1	Curb	{ Cock Value T-S. & V. }	..... in.....	\$ 1 00
7	Service Box	{ Short 3 1/2 x 4 1/2 Old returned Raff. or Redway }	.....	\$ 1 30
25	Ft. 3/4 in.	{ Copper Galv. Iron Cast Iron }	Pipe at.....	\$ 5 70
	Nipples	..... in. at.....		\$
	Bushings	..... to..... in. at.....		\$
	Red'g Inc'g	Couplings..... to..... in. at.....		\$
	Union	..... in. at.....		\$
	Meter	..... in. at.....		\$
	Lbs Br. Stone	at.....		\$
	Lbs. Sand	at.....		\$
	Bags Cement	at.....		\$
	Paving Brick	{ Mack Red Asphalt }	at.....	\$
	Lead Joints	at.....		\$
	Leadite Joints	at.....		\$
1	Hrs. Foreman	at.....		\$ 6 3
2	Hrs. Common Labor	at.....		\$ 8 1
	Hrs. Common Labor	at.....		\$
	Hrs. Mason	at.....		\$
	Hrs Mason's Helper	at.....		\$
	Hrs. Compressor	at.....		\$
	Compensation Ins.	.....		\$ 0 3
	Trucking	.....		\$ 1 0 0
	Builders' Use of Water	.....		\$
Total				\$ 13 47

Labor and Material Report

19 28

44? 34 Peck Ave

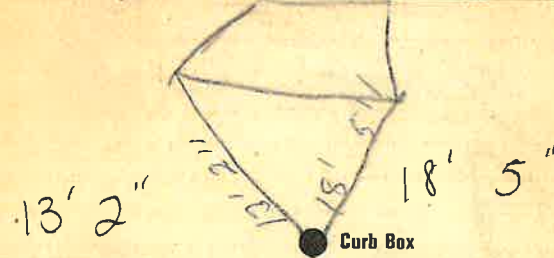

6" Main

Elev. of Main at tap 5'

Gate at ●

● Gate at

● Curb Box

Mrs H. Cahill  
TAX ID# 303.18-10-7