

LABOR AND MATERIALS

1	Copper	Connection	3/4"	\$	2.41
	Lead				
1	Curb	Cock Valve	3/4 in.	\$	2.41
		T-S & V.			
1	Service box	Short 3 1/2 X 4 1/2		\$	4.18
	Old returned	Long 4 1/2 X 5 1/2			
		Buff or Rdway		\$	
16	Ft.	Copper	3/4 in.	Pipe at	40 \$ 6.40
		C.I.			
		C.I.			
	Nipples	in. at		\$	
	Bushings	to in. at		\$	
	Red'g				
	Inc'g	Coupl'gs to in. at		\$	
	Union	in. at		\$	
	Meter	in. at		\$	
	Lead Joints at			\$	
	Compound Joints at			\$	
	Hrs. Water Maint. Man-1 at			\$	
9	Hrs. Water Maint. Man-2 at	1.25		\$	11.16
4	Hrs. Labor- at	1.13		\$	4.52
	Hrs. Labor- at			\$	
	Hrs. Compressor at			\$	
	Compensation Ins. at	\$3.861 per C		\$	6.1
	Trucking			\$	1.50
	Pav't Patch			\$	10.80
	Tap made	4-23-54		\$	
	by	Gilbert & Wedleigh		\$	
	O'head			\$	

\$44.99

34.19

18-54


Peck

St.
Pl.
Ave. No. 49

Name of Owner

Myette

Labor and Mat'l. Report April 23 1954

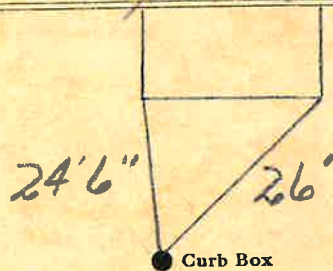

Curb Box

6" Main

Elev. of Main at tap 4 1/2'

Gate at ●

● Gate at

TAX ID # 303.18-4.19.3

● Curb Box