

LABOR AND MATERIALS

Copper	} Connection	_____	\$ _____	
Lead				
Curb	} Cock Valve T. S. & V. }	_____ in.	\$ _____	
Service box		} Short 3½ x 4½ Long 4½ x 5½ }		
Old returned				\$ _____
Ft. 6 in.	} Copper G. I. C. I. }	Pipe at _____	\$ _____	
Nipples _____ in.		at _____	\$ _____	
Bushings _____ to _____ in.	at _____	\$ _____		
Red'g } Inc'g }	} Coupl'gs _____ to _____ in.	at _____	\$ _____	
Union _____ in.		at _____	\$ _____	
Meter _____ in.	at _____	\$ _____		
Compound Joints	at _____	\$ _____		
Maintenance Foreman	_____	\$ _____		
Hrs. Water Maint. Man—1	at _____	\$ _____		
Hrs. Water Maint. Man—2	at _____	\$ _____		
Hrs. Garage Foreman _____	at _____	\$ _____		
Hrs. Labor— _____	at _____	\$ _____		
Hrs. Compressor at _____		\$ _____		
Trucking _____		\$ _____		
Pav't Patch _____		\$ _____		
		\$ _____		
		\$ _____		
		\$ _____		
		\$ _____		

St. _____
Pl. _____
Ave. No. _____

PECK

Name of Owner _____
ASTRO VALCOR

Labor and Mat'l. Report _____ 1989

Main Elev. of Main at tap _____

Gate at • • Gate at _____

• Curb Box

R + D BLDG.

TAP ON PECK AVE

LSM-SC-6-1-67

LABOR AND MATERIALS


Copper	} Connection _____	\$ _____	
Lead			
Curb	} Cock Valve } _____ in. _____	\$ _____	
		} T. S. & V. }	
Service box	} Short 3½ x 4½ } _____	\$ _____	
Old returned			} Long 4½ x 5½ } _____
10 Ft. ^{or} 1 in.	} Copper } Pipe at _____	\$ _____	
			} G.I. }
Nipples _____ in. at _____	\$ _____		
Bushings _____ to _____ in. at _____	\$ _____		
Red'g } Coupl'gs _____ to _____ in. at _____	\$ _____		
Inc'g }			
Union _____ in. at _____	\$ _____		
Meter _____ in. at _____	\$ _____		
Lead Joints at _____	\$ _____		
Compound Joints at _____	\$ _____		
Maintenance Foreman _____	\$ _____		
Hrs. Water Maint. Man-1 at _____	\$ _____		
Hrs. Water Maint. Man-2 at _____	\$ _____		
Hrs. Garage Foreman _____ at _____	\$ _____		
Hrs. Labor _____ at _____	\$ _____		
Hrs. Compressor at _____	\$ _____		
Compensation Ins. at \$ _____ per C _____	\$ _____		
Trucking _____	\$ _____		
Pav't Patch _____	\$ _____		
_____	\$ _____		
_____	\$ _____		
_____	\$ _____		
O'head _____	\$ _____		
_____	\$ _____		

PECK

St. _____
Pl. _____
Ave. No. _____

Name of Owner
VALCOUR

Labor and Mat'l. Report 19

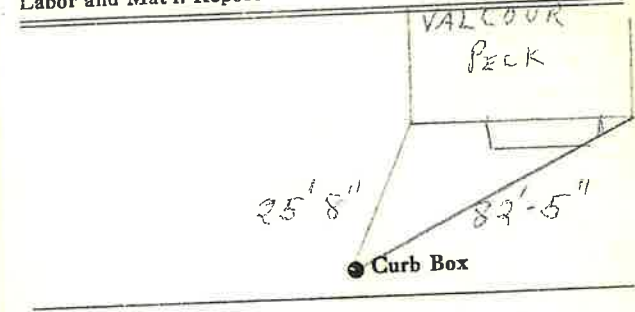

Main Elev. of Main at tap _____

Gate at • • Gate at _____

• Curb Box

This is measurements for the foundation - Building set up as yet. Will have to remove water. Building gate ways.

LSM-5C-6-1-67