


Labor and Materials.

1	Copper } Connection.....	\$ 2 20
1	Lead } Cock } Curb } Valve } S. & }	\$ 1 00
1	Service Box { Short 3 1/2 x 4 1/2 } Old returned { Long 4 1/2 x 5 1/2 } Buff. or Rdway }	\$ 1 30
9	Ft. 9 1/2 in. { Copper } Galv. Iron } Pipe at.....	\$ 198
	Cast Iron }	
	Nipples..... in. at.....	\$
	Bushings..... to..... in. at.....	\$
	Red'g } Couplings..... to..... in. at.....	\$
	Inc'g }	
	Union..... in. at.....	\$
	Meter..... in. at.....	\$
	Lbs. Br. Stone at.....	\$
	Lbs. Sand at.....	\$
	Bags Cement at.....	\$
	Paving Brick { Mack } Red } at.....	\$
	Asphalt }	
	Lead Joints at.....	\$
	Leadite Joints at.....	\$
1 1/2	Hrs. Foreman at.....	\$ 94
12	Hrs. Common Labor at.....	\$ 28
	Hrs. Common Labor at.....	\$
	Hrs. Mason at.....	\$
	Hrs. Mason's Helper at.....	\$
	Hrs. Compressor at.....	\$
	Compensation Ins.....	\$ 15
	Trucking.....	\$ 20
	Builders' Use of Water.....	\$

Total \$148.10

28-166
Labor and Material Report Dec 1 1928

51 1/2 Peck Ave

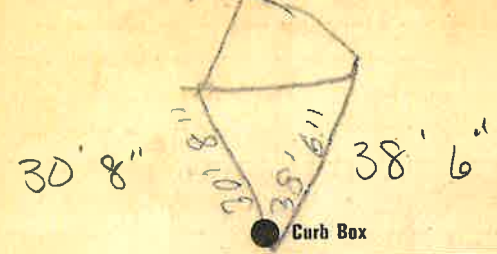

6" Main Elev. of Main at tap 5'
Gate at ● Gate at ●

● Curb Box
TAX ID # 303.18-4-19.1
Peter Myatt