

LABOR AND MATERIALS

Copper	Lead	Connection	3/4	\$	2.87
1	1	Curb	Cock Valve T. S. & V. } 3/4 in.	\$	3.62
1	1	Service box Old returned	Short 3 1/2 X 4 1/2 } Long 4 1/2 X 5 1/2 } Buff or Rdway }	\$	4.68
25	Ft.	3/8 in.	Copper } C. I. } C. I. }	Pipe at	32 \$ 8.00
	Nipples	in. at		\$	
	Bushings	to in. at		\$	
	Red'g			\$	
	Inc'g	Coupl'gs to in. at		\$	
	Union	in. at		\$	
	Meter	in. at		\$	
	Lead Joints	at		\$	
	Compound Joints	at		\$	
	Hrs. Water Maint. Man-1	at		\$	
5	Hrs. Water Maint. Man-2	at	102	\$	5.10
26	Hrs. Labor	at	91	\$	23.66
	Hrs. Labor	at		\$	
	Hrs. Compressor	at		\$	
	Compensation Ins.	at \$ per C		\$.63
	Trucking			\$	2.00
	Pav't Patch			\$	10.25
	Tax			\$	
	O'head			\$	
				\$	60.81

43

Beck


Ave. No. 52

Name of Owner

Del Monaco - GARDEN TAP

Labor and Mat'l. Report

JUNE 8 1949

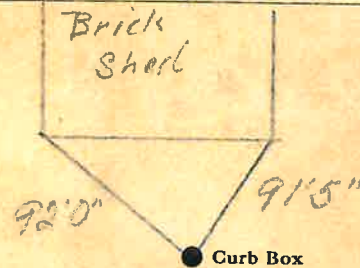

● Curb Box

6 Main

Elev. of Main at tap 5

Gate at ● Gate at

TAX ID # 303.18-10-10

● Curb Box

REPLACED CURB STOP - JULY 2000