

LABOR AND MATERIALS


{ Copper } Connection _____ \$ _____
 { Lead } _____ \$ _____
 3/4" Curb } Cock } _____ in. _____ \$ _____
 { Valve } _____ \$ _____
 { T.S. & V. } _____ \$ _____
 Service box { Short 3-1/2 x 4-1/2 } _____ \$ _____
 Old returned { Long 4-1/2 x 5-1/2 } _____ \$ _____
 18' Ft. _____ in. { Copper } Pipe at _____ \$ _____
 { G.I. } _____ \$ _____
 { C.I. } _____ \$ _____
 _____ Nipples _____ in. at _____ \$ _____
 _____ Bushings _____ to _____ in. at _____ \$ _____
 _____ Red'g _____ \$ _____
 _____ Inc'g _____ \$ _____
 _____ Union _____ in. at _____ \$ _____
 _____ Meter _____ in. at _____ \$ _____
 _____ \$ _____
 _____ Compound Joints at _____ \$ _____
 _____ Maintenance Foreman _____ \$ _____
 _____ Hrs. Water Maint. Man - 1 at _____ \$ _____
 _____ Hrs. Water Maint. Man - 2 at _____ \$ _____
 _____ Hrs. Garage Foreman _____ at _____ \$ _____
 _____ Hrs. Labor _____ at _____ \$ _____
 _____ Hrs. Compressor at _____ \$ _____
 _____ \$ _____
 _____ Trucking _____ \$ _____
 _____ Pav't Patch _____ \$ _____
 _____ \$ _____
 _____ \$ _____
Peck

St. Ave. No. 53

Name of Owner

Labor and Mat'l. Report 2/11 2015

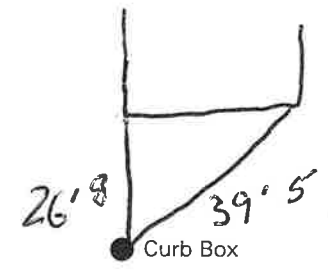

6" Main

Elev. of Main at tap 6'5"

Gate at ● Gate at ●

TAX ID# 303.18-4-19.2

● Curb Box