

Labor and Materials

1	Copper	Connection	2/4	\$	3.20
1	Lead				
1	Curb	Cock Valve	3/4 in.	\$	1.00
		T.S. & V.			
1	Service Box	Short 3/4x1 1/2		\$	1.30
	Old returned	Long 4 1/2x5 1/2			
		Buff. or Rdway			
9	Ft.	3/4 in.	Copper Galv. Iron Pipe at	\$	1.98
	Nipples	in. at		\$	
	Bushings	to in. at		\$	
	Red'g Inc'g	Couplings	to in. at	\$	
	Union	in. at		\$	
	Meter	in. at		\$	
	Lbs. Br. Stone	at		\$	
	Lbs. Sand	at		\$	
	Bags Cement	at		\$	
	Paving Brick	Mack Red Asphalt	at	\$	
	Lead Joints	at		\$	
	Leadite Joints	at		\$	
1 1/2	Hrs. Foreman	at		\$	94
12	Hrs. Common Labor	at		\$	488
	Hrs. Common Labor	at		\$	
	Hrs. Mason	at		\$	
	Hrs. Mason's Helper	at		\$	
	Hrs. Compressor	at		\$	
	Compensation Ins.			\$	15
	Trucking			\$	200
	Builders' Use of Water			\$	
Total \$					1415


78-172

Labor and Material Report

Dec 1

1928

5718 Beck Ave

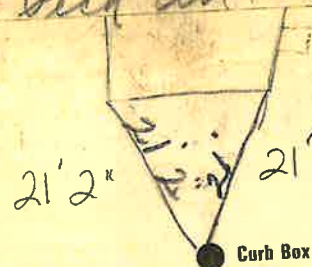

6" Main

Elev of Main at tap

5'

Gate at ●

● Gate at

● Curb Box

TAX ID# 303.18-4-17

Sam Jenkins