

LABOR AND MATERIALS


Copper	Lead	Connection		\$
Curb	Cock Valve	T. S. & V.	in.	\$
Service box	Old returned	Short 3½ x 4½	Long 4½ x 5½	\$
13 Ft.	¾ in.	Copper	Pipe at	\$
		G.I.		\$
		G.I.		\$
Nipples	in.	at		\$
Bushings	to	in.	at	\$
Red'g	Inc'g	Coupl'gs	to in. at	\$
Union	in.	at		\$
Meter	in.	at		\$
				\$
Compound Joints	at			\$
Maintenance Foreman				\$
Hrs. Water Maint. Man-1	at			\$
Hrs. Water Maint. Man-2	at			\$
Hrs. Garage Foreman	at			\$
Hrs. Labor	at			\$
Hrs. Compressor	at			\$
				\$
Trucking				\$
Pav't Patch				\$
				\$
				\$
PECK

St. _____
Pl. _____
Ave. No. 58

Name of Owner
LARRY CLUTE

Labor and Mat'l. Report 1999

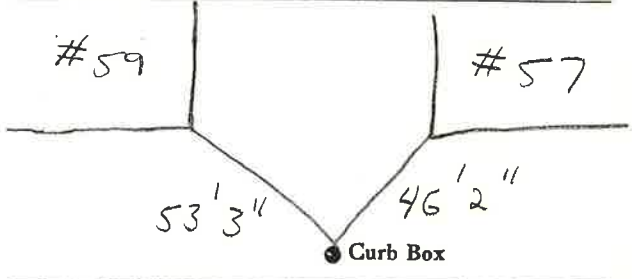

6" Main #58 Elev. of Main at tap 5'

Gate at ● ● Gate at

● Curb Box