

LABOR AND MATERIALS


Copper	} Connection	_____	\$ _____	
Lead				
Curb	} Cock	_____ in.	\$ _____	
				} Valve
Service box	} Short 3 1/2 x 4 1/2	_____	\$ _____	
Old returned				Long 4 1/2 x 5 1/2
14 Ft. 3/4 in.	} Pipe at	_____	\$ _____	
		G.I.		
		G.I.		
Nipples	_____ in. at	_____	\$ _____	
Bushings	_____ to _____ in. at	_____	\$ _____	
Red'g	} Coupl'gs	_____ to _____ in. at	\$ _____	
Inc'g				
Union	_____ in. at	_____	\$ _____	
Meter	_____ in. at	_____	\$ _____	
			\$ _____	
Compound Joints	at	_____	\$ _____	
Maintenance Foreman		_____	\$ _____	
Hrs. Water Maint. Man-1	at	_____	\$ _____	
Hrs. Water Maint. Man-2	at	_____	\$ _____	
Hrs. Garage Foreman	at	_____	\$ _____	
Hrs. Labor	at	_____	\$ _____	
Hrs. Compressor	at	_____	\$ _____	
			\$ _____	
Trucking		_____	\$ _____	
Pav't Patch		_____	\$ _____	
			\$ _____	
			\$ _____	
			\$ _____	
			\$ _____	

PECK

St. _____
Pl. _____
Ave. No. 59

Name of Owner
Larry Clute

Labor and Mat'l. Report 19 99

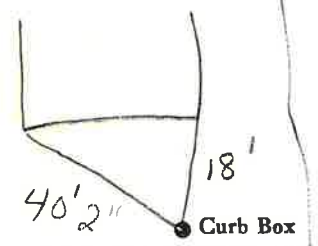

6" Main Elev. of Main at tap 5'
Gate at • Gate at

TAX ID# 303.18-4-16

• Curb Box

