

LABOR AND MATERIALS

Copper	} Connection	_____	\$ _____		
Lead					
Curb	} Cock	_____ in.	\$ _____		
				} Valve	_____
Service box	} Short 3½ x 4½	_____	\$ _____		
				Old returned	Long 4½ x 5½
Ft. <u>3/4</u> in.	} Copper	_____	\$ _____		
Nipples	_____ in. at _____	\$ _____			
Bushings	_____ to _____ in. at _____	\$ _____			
Red'g	} Coupl'gs _____ to _____ in. at _____	\$ _____			
Inc'g					
Union	_____ in. at _____	\$ _____			
Meter	_____ in. at _____	\$ _____			
Compound Joints	at _____	\$ _____			
Maintenance Foreman	_____	\$ _____			
Hrs. Water Maint. Man-1	at _____	\$ _____			
Hrs. Water Maint. Man-2	at _____	\$ _____			
Hrs. Garage Foreman	at _____	\$ _____			
Hrs. Labor	_____ at _____	\$ _____			
Hrs. Compressor	at _____	\$ _____			
Trucking	_____	\$ _____			
Pav't Patch	_____	\$ _____			
		\$ _____			
		\$ _____			
PECK


Ave. No. 60

Name of Owner

TAX ID # 303.18-3-3

Labor and Mat'l. Report

6-13 <sup>2000</sup> ~~19~~

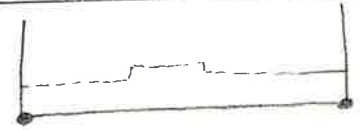

59 1/6"      63 1/2"

● Curb Box

_____ Main	Elev. of Main at tap _____
Gate at ●	● Gate at

● Curb Box