


LABOR AND MATERIALS

1	Copper Lead	Connection	\$
1	Curb	Cock Valve T.S. & V. } in.	\$
1	Service box Old returned	Short 3 1/2 x 4 1/2 Long 4 1/2 x 5 1/2 }	\$
9	Ft. 3 in.	{ Copper C.I. C.I. } Pipe at	\$
	Nipples	in. at	\$
	Bushings	to in. at	\$
	Red'g Inc'g }	Coupl'gs to in. at	\$
	Union	in. at	\$
	Meter	in. at	\$
			\$
	Compound Joints	at	\$
	Maintenance Foreman		\$
	Hrs. Water Maint. Man-1	at	\$
	Hrs. Water Maint. Man-2	at	\$
	Hrs. Garage Foreman	at	\$
	Hrs. Labor	at	\$
	Hrs. Compressor	at	\$
			\$
	Trucking		\$
	Pav't Patch		\$
			\$
			\$
PECK ~~St.~~ ~~Pl.~~ Ave. No. 61

Name of Owner BULLARD

Labor and Mat'l. Report DEC 1 19 28

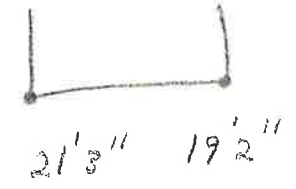

● Curb Box

6" Main Elev. of Main at tap 5'

Gate at ● ● Gate at

TAX ID# 303.18-4-15

● Curb Box