

LABOR AND MATERIALS


1	Copper Lead	Connection	3/4"	\$
1	Curb	Cock Valve T.S. & V.	3/4 in. 0-15 cat.	\$
1	Service box	Short 3 1/2 x 4 1/2		\$
	Old returned	Long 4 1/2 x 5 1/2		\$
		Buff or Rdway		\$
13	Ft. 3/4 in.	Copper G.I. C.I. Pipe at		\$
	Nipples	in. at		\$
	Bushings	to in. at		\$
	Red'g Inc'g	Coupl'gs to in. at		\$
	Union	in. at		\$
	Meter	in. at		\$
	Lead Joints	at		\$
	Compound Joints	at		\$
	Maintenance Foreman			\$
	Hrs. Water Maint. Man-1	at		\$
	Hrs. Water Maint. Man-2	at		\$
	Hrs. Garage Foreman	at		\$
	Hrs. Labor	at		\$
	Hrs. Compressor	at		\$
	Compensation Ins.	at \$ per C		\$
	Trucking			\$
	Pav't Patch			\$
	Tap by Larcavt Co.			\$
				\$
				\$
	O'head			\$
				\$

11-10-70.

St. Rock
 Pl. 65
 Ave. No. 65

Name of Owner Roney & Klarnas.

Labor and Mat'l. Report Nov. 10 1970

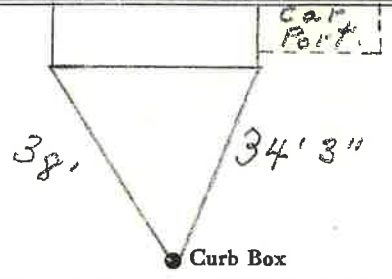

6" Main Elev. of Main at tap 4'

Gate at • Gate at •

TAX ID# 303.18-4-13

• Curb Box