

LABOR AND MATERIALS

Copper } Connection 8-20-03 \$ _____
 Curb } Cock } _____ in. \$ _____
 } Valve } _____
 } T.S. & V. } _____
 Service box { Short 3-1/2 x 4-1/2 } _____ \$ _____
 Old returned { Long 4-1/2 x 5-1/2 } _____ \$ _____
22 Ft. 3/4 in. { Copper } Pipe at _____ \$ _____
 Nipples _____ in. at _____ \$ _____
 Bushings _____ to _____ in. at _____ \$ _____
 Red'g _____
 Inc'g _____
 Union _____ in. at _____ \$ _____
 Meter _____ in. at _____ \$ _____
 _____ \$ _____
 Compound Joints at _____ \$ _____
 Maintenance Foreman _____ \$ _____
 Hrs. Water Maint. Man - 1 at _____ \$ _____
 Hrs. Water Maint. Man - 2 at _____ \$ _____
 Hrs. Garage Foreman _____ at _____ \$ _____
 Hrs. Labor _____ at _____ \$ _____
 Hrs. Compressor at _____ \$ _____
 _____ \$ _____
 Trucking _____ \$ _____
 Pav't Patch _____ \$ _____
 _____ \$ _____
 _____ \$ _____
68


#68

PECK

Ave. No. ~~XXXX~~

Name of Owner
Ruth Quintais

Labor and Mat'l. Report 8-20-3
2003

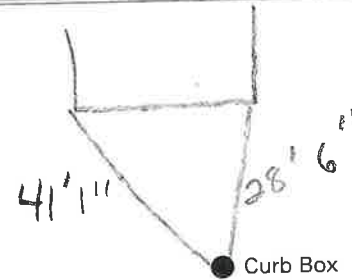

_____ Main Elev. of Main at tap _____
 Gate at ● ● Gate at
TAX ID # 303.183-6

 ● Curb Box