

LABOR AND MATERIALS

Copper } Connection _____	\$ _____
Lead } _____	\$ _____
Curb } Cock _____	\$ _____
} Valve _____	in. _____
} T. S. & V. _____	\$ _____
Service box } Short 3 1/2 x 4 1/2 _____	\$ _____
Old returned } Long 4 1/2 x 5 1/2 _____	\$ _____
21 1/4" Ft. 3/4 in. } Copper _____	\$ _____
} C.I. _____	Pipe at _____
} C.I. _____	\$ _____
Nipples _____ in. at _____	\$ _____
Bushings _____ to _____ in. at _____	\$ _____
Red'g } _____	\$ _____
Inc'g } Coupl'gs _____ to _____ in. at _____	\$ _____
Union _____ in. at _____	\$ _____
Meter _____ in. at _____	\$ _____
_____	\$ _____
Compound Joints at _____	\$ _____
Maintenance Foreman _____	\$ _____
Hrs. Water Maint. Man-1 at _____	\$ _____
Hrs. Water Maint. Man-2 at _____	\$ _____
Hrs. Garage Foreman _____ at _____	\$ _____
Hrs. Labor _____ at _____	\$ _____
Hrs. Compressor at _____	\$ _____
_____	\$ _____
Trucking _____	\$ _____
Pav't Patch _____	\$ _____
_____	\$ _____
_____	\$ _____
_____	\$ _____
_____	\$ _____


PECK

St. _____
Pl. _____
Ave. No. 70

Name of Owner _____

Labor and Mat'l. Report

5-3 2000
19

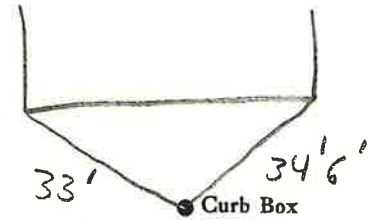

● Curb Box

6" Main

Elev. of Main at tap 5'

Gate at ●

● Gate at

● Curb Box