

LABOR AND MATERIALS

Copper	} Connection		\$
Lead			
Curb	} Cock Valve T. S. & V.	in.	\$
Service box		} Short 3½ x 4½ Long 4½ x 5½	
Old returned			
20'8" Ft. 3/4 in.	} Copper C.I.	Pipe at	\$
Nipples		in. at	\$
Bushings	to in. at	\$	
Red'g Inc'g	} Coupl'gs	to in. at	\$
Union		in. at	\$
Meter	in. at	\$	
Compound Joints	at	\$	
Maintenance Foreman		\$	
Hrs. Water Maint. Man-1	at	\$	
Hrs. Water Maint. Man-2	at	\$	
Hrs. Garage Foreman	at	\$	
Hrs. Labor	at	\$	
Hrs. Compressor	at	\$	
Trucking		\$	
Pav't Patch		\$	
		\$	
		\$	
PECK


St. 74
Ave. No.

Name of Owner

TAX ID # 303.18-3-9

Labor and Mat'l. Report

5-2 2000
-19

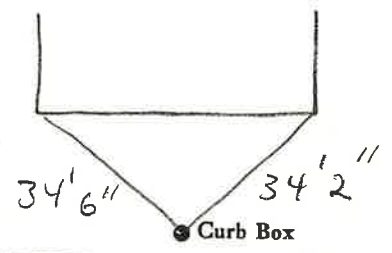

6" Main

Elev. of Main at tap 5'

Gate at ●

● Gate at

● Curb Box

SEWER SERVICE 5' FROM
WATER SERVICE

LSM-5C-6-1-67