

LABOR AND MATERIALS


Copper } Connection _____	\$ _____
Lead } _____	\$ _____
Curb } Cock Valve } _____ in.	\$ _____
} T.S. & V. } _____	\$ _____
Service box } Short 3 1/2 x 4 1/2 }	\$ _____
Old returned } Long 4 1/2 x 5 1/2 }	\$ _____
Ft. 3/4 in. } Copper } Pipe at _____	\$ _____
} C.I. }	
} C.I. }	
Nipples _____ in. at _____	\$ _____
Bushings _____ to _____ in. at _____	\$ _____
Red'g } Coupl'gs _____ to _____ in. at _____	\$ _____
Inc'g } _____	\$ _____
Union _____ in. at _____	\$ _____
Meter _____ in. at _____	\$ _____
_____	\$ _____
Compound Joints at _____	\$ _____
Maintenance Foreman _____	\$ _____
Hrs. Water Maint. Man—1 at _____	\$ _____
Hrs. Water Maint. Man—2 at _____	\$ _____
Hrs. Garage Foreman _____ at _____	\$ _____
Hrs. Labor— _____ at _____	\$ _____
Hrs. Compressor at _____	\$ _____
_____	\$ _____
Trucking _____	\$ _____
Pav't Patch _____	\$ _____
_____	\$ _____
_____	\$ _____
PECK St. _____
Pt. _____
Ave. No. 27

Name of Owner _____

TAX ID # 303.18-4-8

Labor and Mat'l. Report 19 95

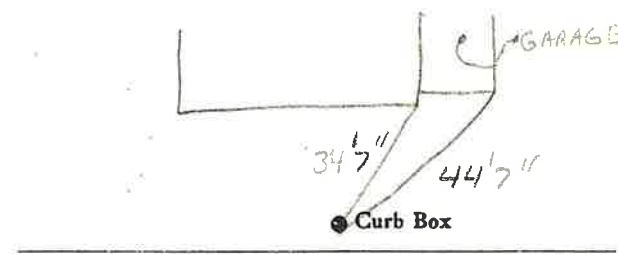

_____ Main	Elev. of Main at tap _____
Gate at ●	● Gate at

● Curb Box