

LABOR AND MATERIALS

1 Copper } Connection 3/4" \$
~~1~~ }
 1 Curb } Cock Valve } 3/4 in. MARK II OR SEAL \$
 1 Service box { Short 3 1/2 x 4 1/2 } \$
 Old returned { Long 4 1/2 x 5 1/2 }
50 Ft. 3/4 in. { Copper } Pipe at \$
 { ~~C.P.~~ }
 Nipples in. at \$
 Bushings to in. at \$
 Red'g } Coupl'gs to in. at \$
 Inc'g }
 Union in. at \$
 Meter in. at \$
 Lead Joints at \$
 Compound Joints at \$
 Maintenance Foreman \$
 Hrs. Water Maint. Man-1 at \$
 Hrs. Water Maint. Man-2 at \$
 Hrs. Garage Foreman at \$
 Hrs. Labor at \$
 Hrs. Compressor at \$
 Compensation Ins. at \$ per C \$
 Trucking \$
 Pav't Patch \$
TAP MADE BY PECK & CO \$
O'head MAY 16-1972 \$

Peck

St. Ave. No. 9


Name of Owner

CHARLES JOHN

Labor and Mat'l. Report

MAY 16 1972

House moved to Haskell Ave. 42'

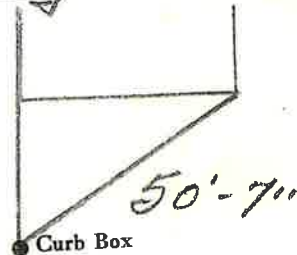

● Curb Box

6" Main

Elev. of Main at tap 4'

Gate at ●

● Gate at

● Curb Box