


Labor and Materials

1	Copper	Connection	3/4	\$
1	Lead			\$
1	Curb	Cock Valve	3/4 in.	\$
1	Service Box	Short 3/2x4 1/2		\$
	Old returned	Long 4 1/2x5 1/2		\$
		Buff. or Rdway		\$
12	Pt.	Copper Galv. Iron	3/4 in. Pipe at	\$
		Cast Iron		\$
	Nipples	in. at		\$
	Bushings	to in. at		\$
	Red'g Inc'g	Couplings to in. at		\$
	Union	in. at		\$
	Meter	in. at		\$
	Lbs. Br. Stone	at		\$
	Lbs. Sand	at		\$
	Bags Cement	at		\$
	Paving Brick	Mack Red Asphalt at		\$
	Lead Joints	at		\$
	Leadite Joints	at		\$
	Hrs. Foreman	at		\$
2	Hrs. Common Labor	at		\$
	Hrs. Common Labor	at		\$
	Hrs. Mason	at		\$
	Hrs. Mason's Helper	at		\$
	Hrs. Compressor	at		\$
	Compensation Ins.			\$
	Trucking			\$
	Builders' Use of Water			\$
Total \$				\$

HAS outside
clean out 32
sewer

30 Peck Ave *Rear House*
Has Kell Ave

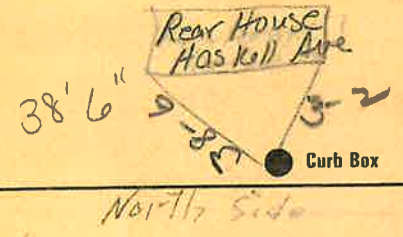

Gate at *6* Main Elev of Main at tap *4 ft*
Gate at TAX ID # 303.18-4-37 Gate at

● Curb Box

Part Payment
for Right of Way

Patoy (Little)
Francol &