

LABOR AND MATERIALS

1	Copper	} Connection	1/2" 3/4"	\$
1	Curb			Cock Valve
			3/4 in. (NIPPLES COPPER CAP)	\$
1	Service box	} Short 3 1/2 x 4 1/2	Buf or Rdway	\$
	Old returned			Long 4 1/2 x 5 1/2
17	3/4 Ft.	} Copper	} Pipe at	\$
				C.I.
	Nipples	in. at		\$
	Bushings	to in. at		\$
	Red'g	} Coupl'gs	to in. at	\$
	Inc'g			\$
	Union	in. at		\$
	Meter	in. at		\$
	Lead Joints at			\$
	Compound Joints at			\$
	Maintenance Foreman			\$
	Hrs. Water Maint. Man-1 at			\$
	Hrs. Water Maint. Man-2 at			\$
	Hrs. Garage Foreman at			\$
	Hrs. Labor at			\$
	Hrs. Compressor at			\$
	Compensation Ins. at \$	per C		\$
	Trucking			\$
	Pav't Patch			\$
	TAP MADE BY GIFFORD & CO			\$
	O'head	OCT. 17-1973		\$


Philo

Ave. No. 1

Name of Owner

Richard K. DEAN

Labor and Mat'l. Report Oct-17 1973

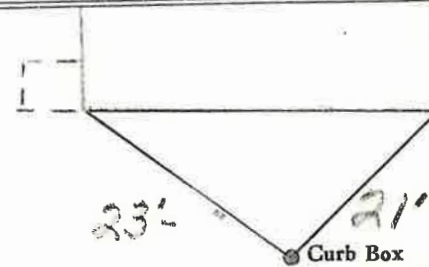

1 1/4" Main

Elev. of Main at tap 5 1/2'

Gate at ●

● Gate at

● Curb Box

TAX ID # 302.15-3-13