

LABOR AND MATERIALS


1- 2" X 1" GALV. Tee.
 1 Copper } Connection 3/4" \$
 1 Lead } Cock } Male Adapter
 1 Curb } Valve } 3/4" in. \$
 } T.S. & V. }
 1 Service box { Short 3 1/2 x 4 1/2 }
 Old returned { Long 4 1/2 x 5 1/2 } \$
 } Buff or Rdway }
 22 3/4 Ft. 3/4 in. { Copper } Pipe at \$
 } G.I. }
 } G.I. }
 2 Nipples 2 in. at Galv \$
 1 Bushings 1 to 3/4 in. at \$
 Red'g } Coupl'gs to in. at \$
 Inc'g } ~~BRASS~~
 1 Union 1/2 in. at Galv Dipple \$
 Meter in. at \$
 Lead Joints at \$
 Compound Joints at \$
 Maintenance Foreman \$
 Hrs. Water Maint. Man-1 at \$
 Hrs. Water Maint. Man-2 at \$
 Hrs. Garage Foreman at \$
 Hrs. Labor at \$
 Hrs. Compressor at \$
 Compensation Ins. at \$ per C \$
 Trucking \$
 Pav't Patch \$
 O'head \$
 2- 2" Dresser \$
 Repair Sleeves
 1- 1" Curb Stop (Used)
 For Corp Stop iron to iron

Phila

St. ~~Pl.~~
 Ave. No. 5

Name of Owner
 Francis X. Chenier

Labor and Mat'l. Report Aug. 1 1962

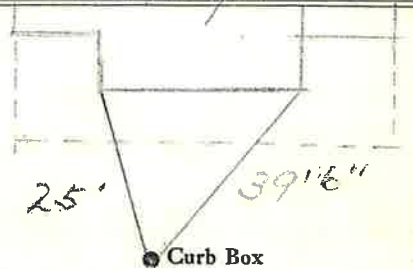

1 1/4" Copper 1978
 Main Elev. of Main at tap 4 1/2'

Gate at • Gate at

TAX ID # 302.15-8-1

• Curb Box